


T.35 S., R. 21 E., W.M.

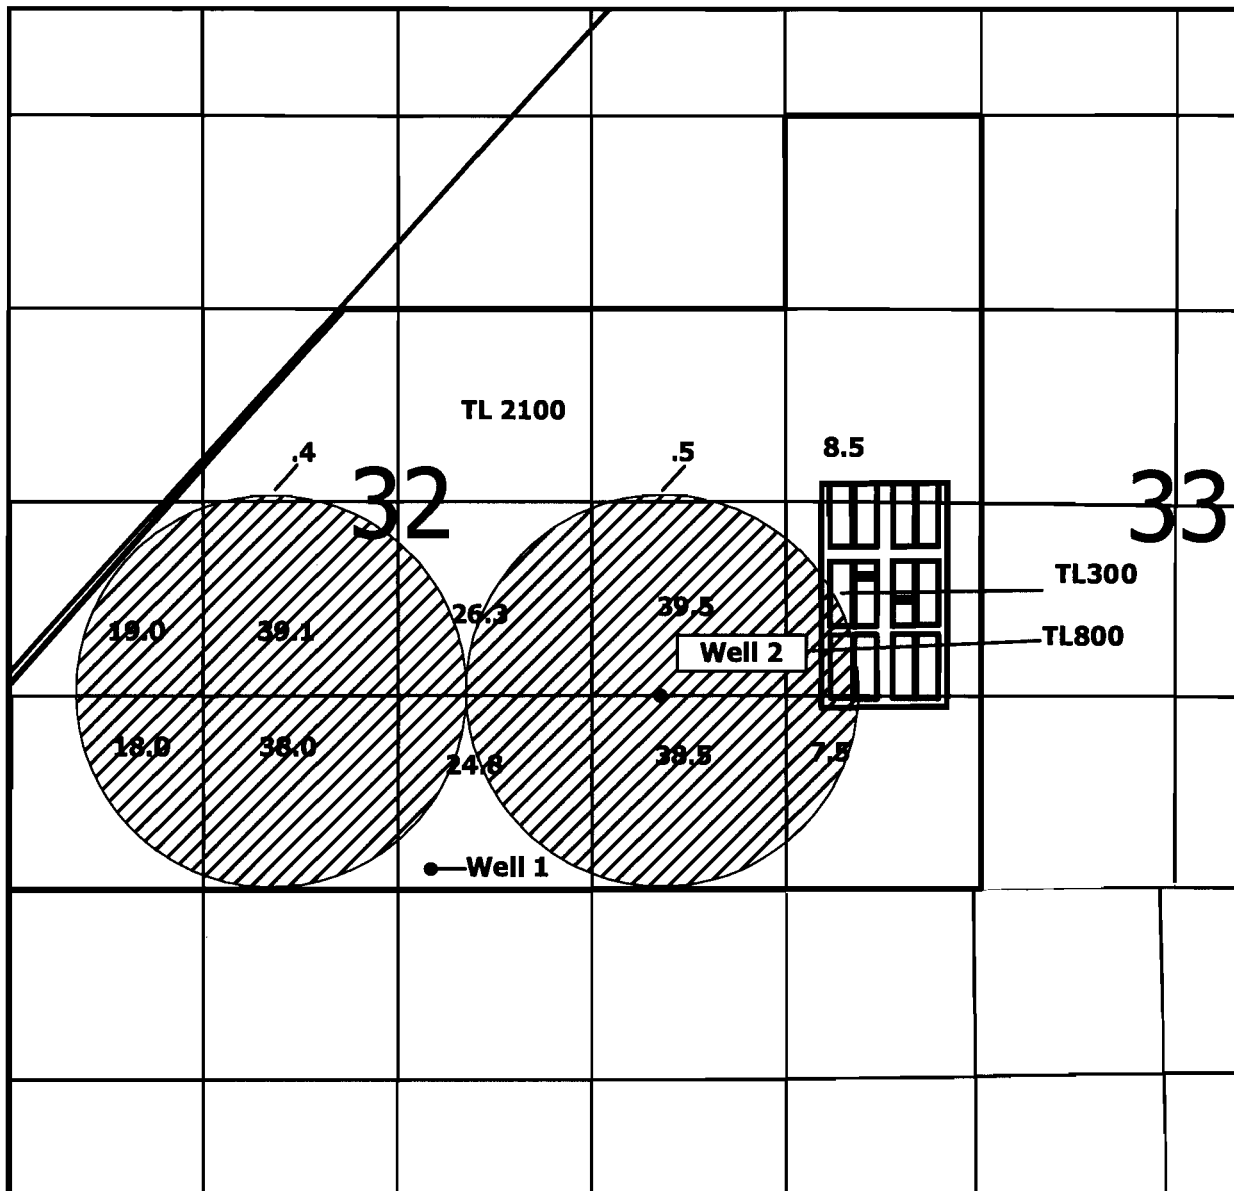

1 inch equals 1,320 feet

Well 1 is located 2440 feet West and 142 feet North of the SE corner of section 32.

Well 2 is located 1330 feet North and 865 feet West of the SE corner of section 32

RECEIVED

APR 09 2012

WATER RESOURCES DEPT
SALEM, OREGON

G-17548

RECEIVED

MAR 15 2012

WATER RESOURCES DEPT
SALEM, OREGON

