


5-27-12

N
scale 1" = 100'

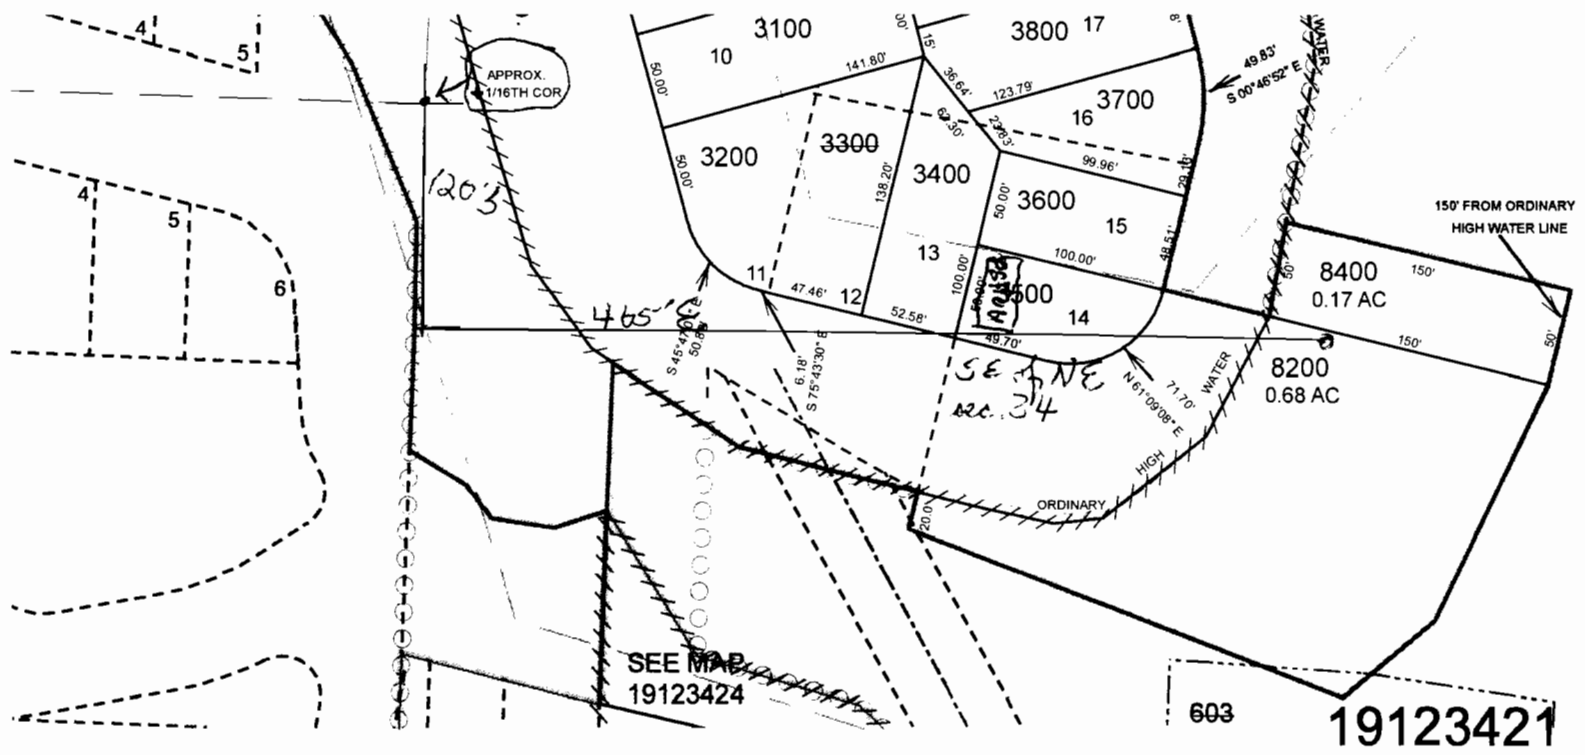

19-12-34-21-03500
120'S 465' E of 1/16th cor.

RECEIVED
APR 9 0 2012
WATER RESOURCES DEPT
SALEM, OREGON


WORK COPY

ADDED TO FILE *YB*



scale 1" = 100'

S-87824

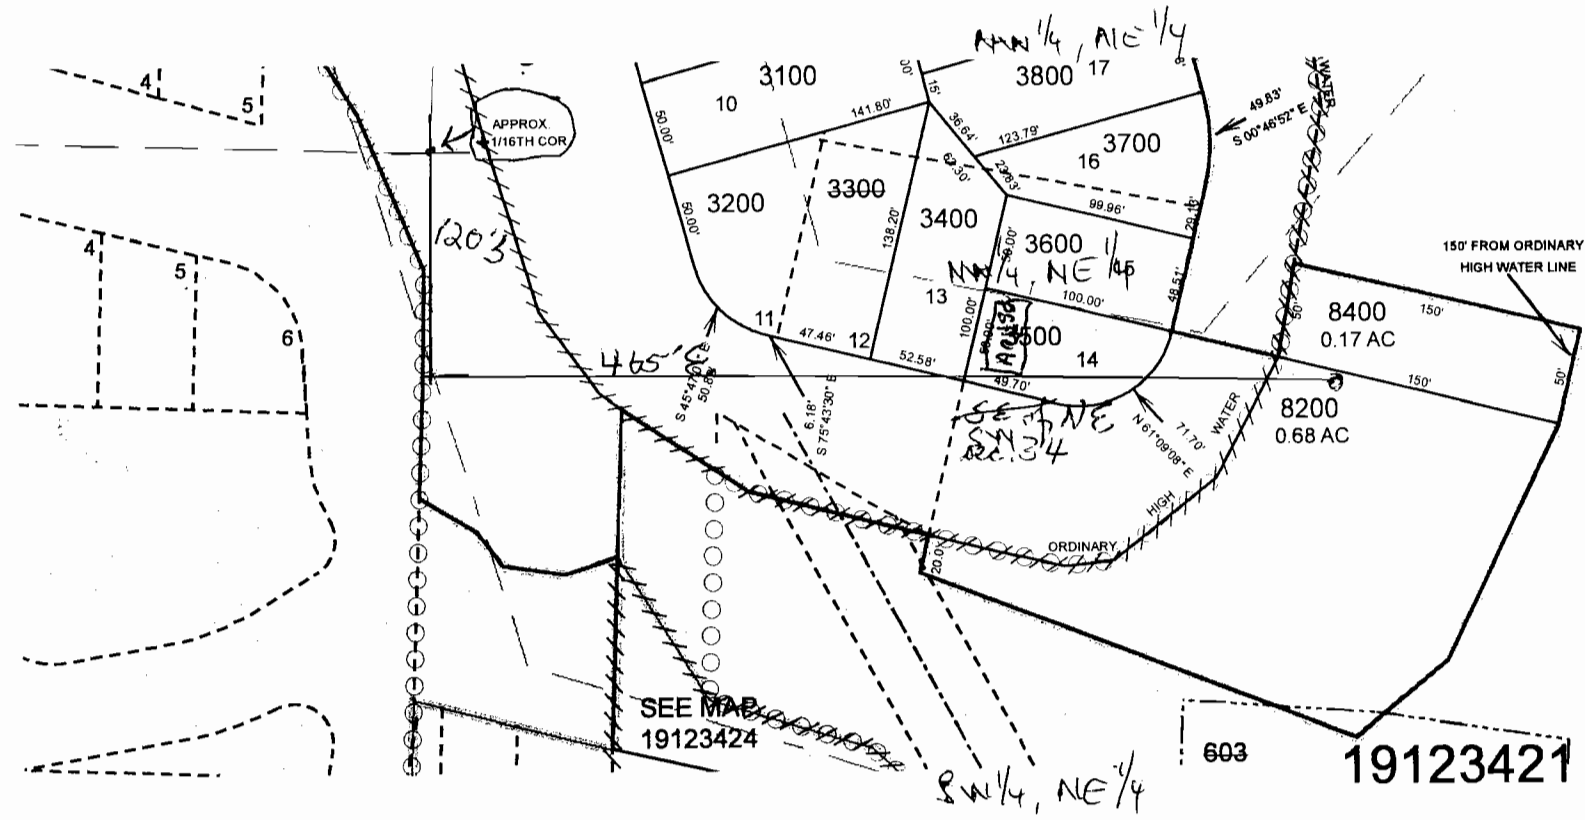


19-12-34-21-03500
120'S 465' E of 1/16th COR.

RECEIVED
APR 30 2012
WATER RESOURCES DEPT
SALEM, OREGON

PLOT PLAN

Township: 19 Range: 12 Section: 34 Quarter: 21 Tax Lot: 03500
Property Address: 82800 OCEAN BLVD

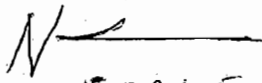

SCALE $\square \approx 5'$

PREPARED OCT 20, 2006

----- Proposed waterline to point of diversion

RECEIVED

APR 30 2012

WATER RESOURCES DEPT
SALEM, OREGON

