


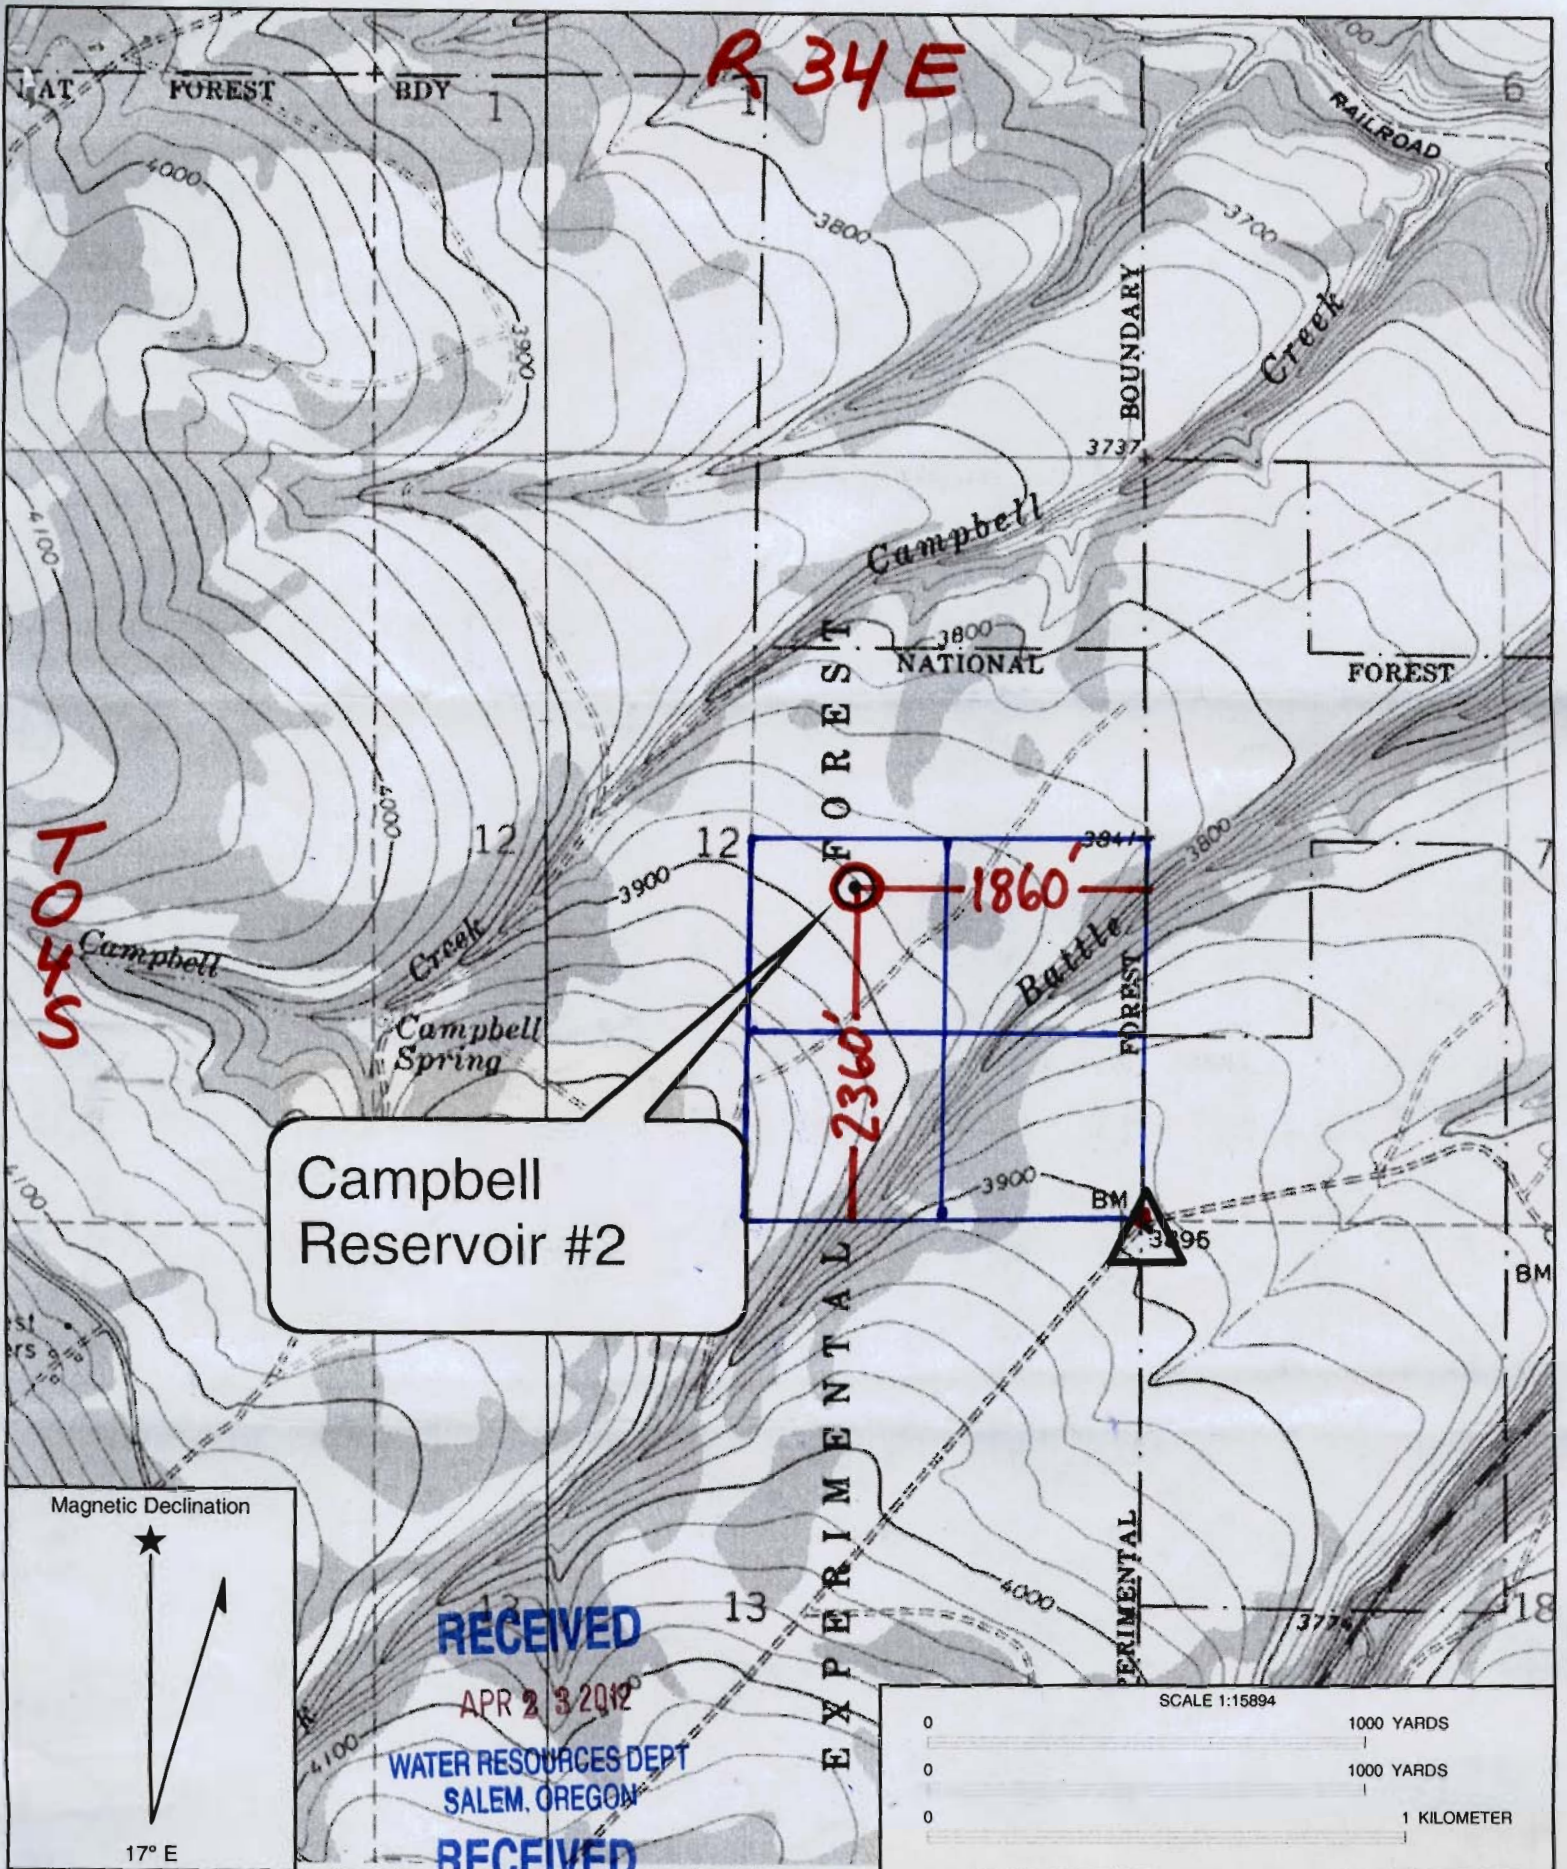

Name: MARLEY CREEK
Date: 1/10/2012
Scale: 1 inch equals 1325 feet

RECEIVED
APR 23 2012
WATER RESOURCES DEPT
SALEM, OREGON
RECEIVED
FEB 02 2012
WATER RESOURCES DEPT
SALEM, OREGON

Location: 11 0382741 E 5009521 N NAD27
Caption: Campbell Reservoir #2

① Marks center of Reservoir