


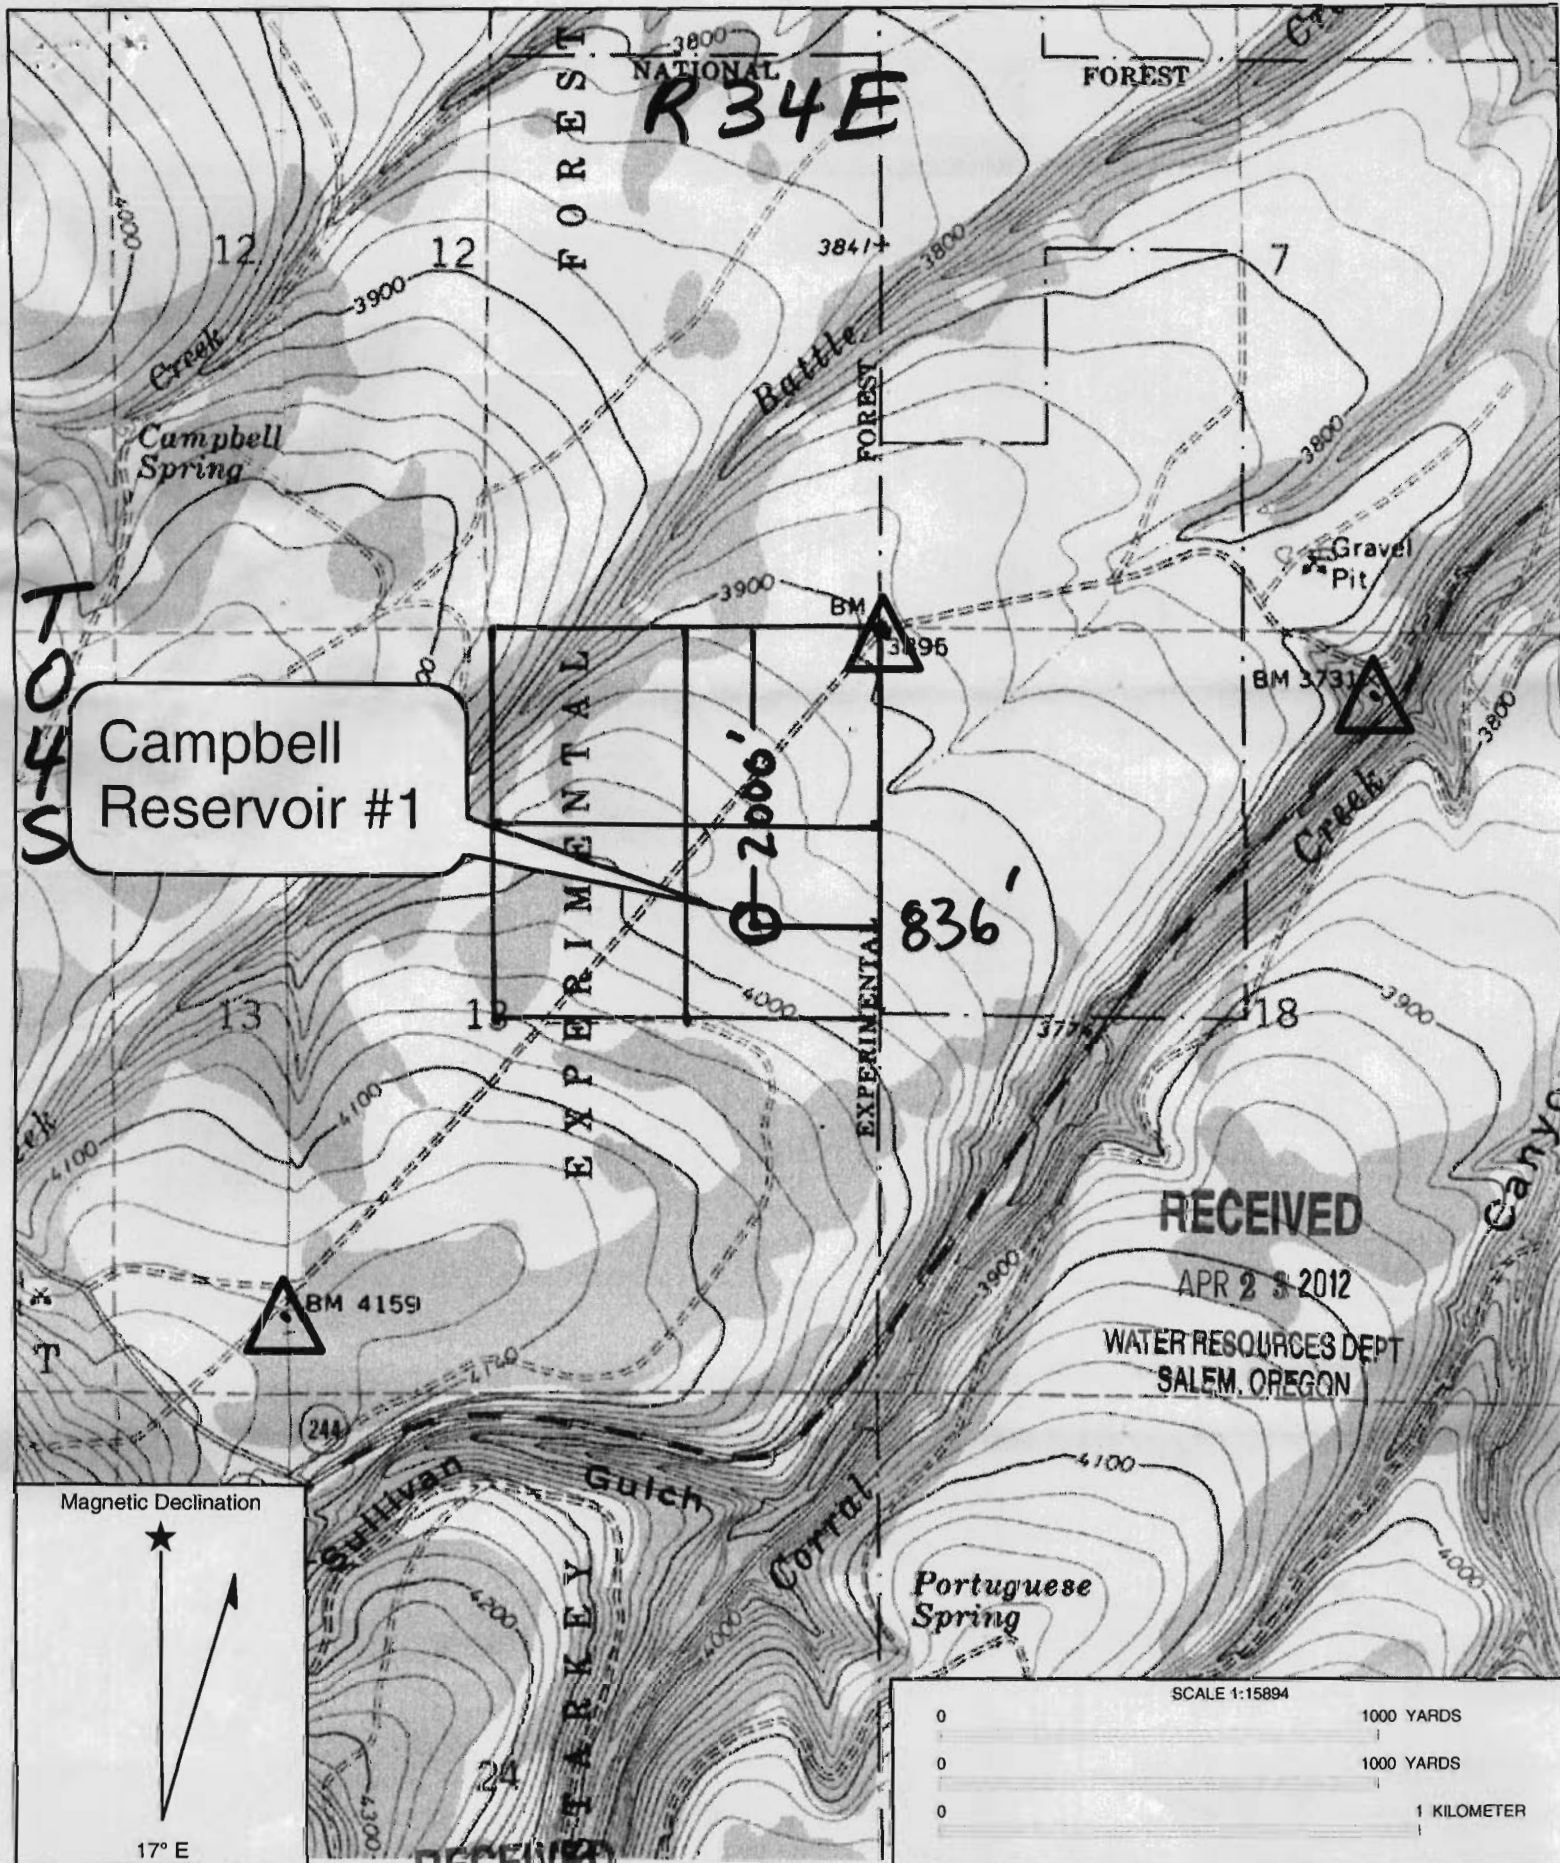

Name: MARLEY CREEK
 Date: 1/10/2012
 Scale: 1 inch equals 1325 feet

FEB 02 2012

Location: 11 0383279 E 5008269 N NAD27
 Caption: Campbell Reservoir #1

WATER RESOURCES DEPT
 SALEM, OREGON

⊙ Marks center of reservoir

Copyright (C) 1997, Maptech, Inc.

R-87779