


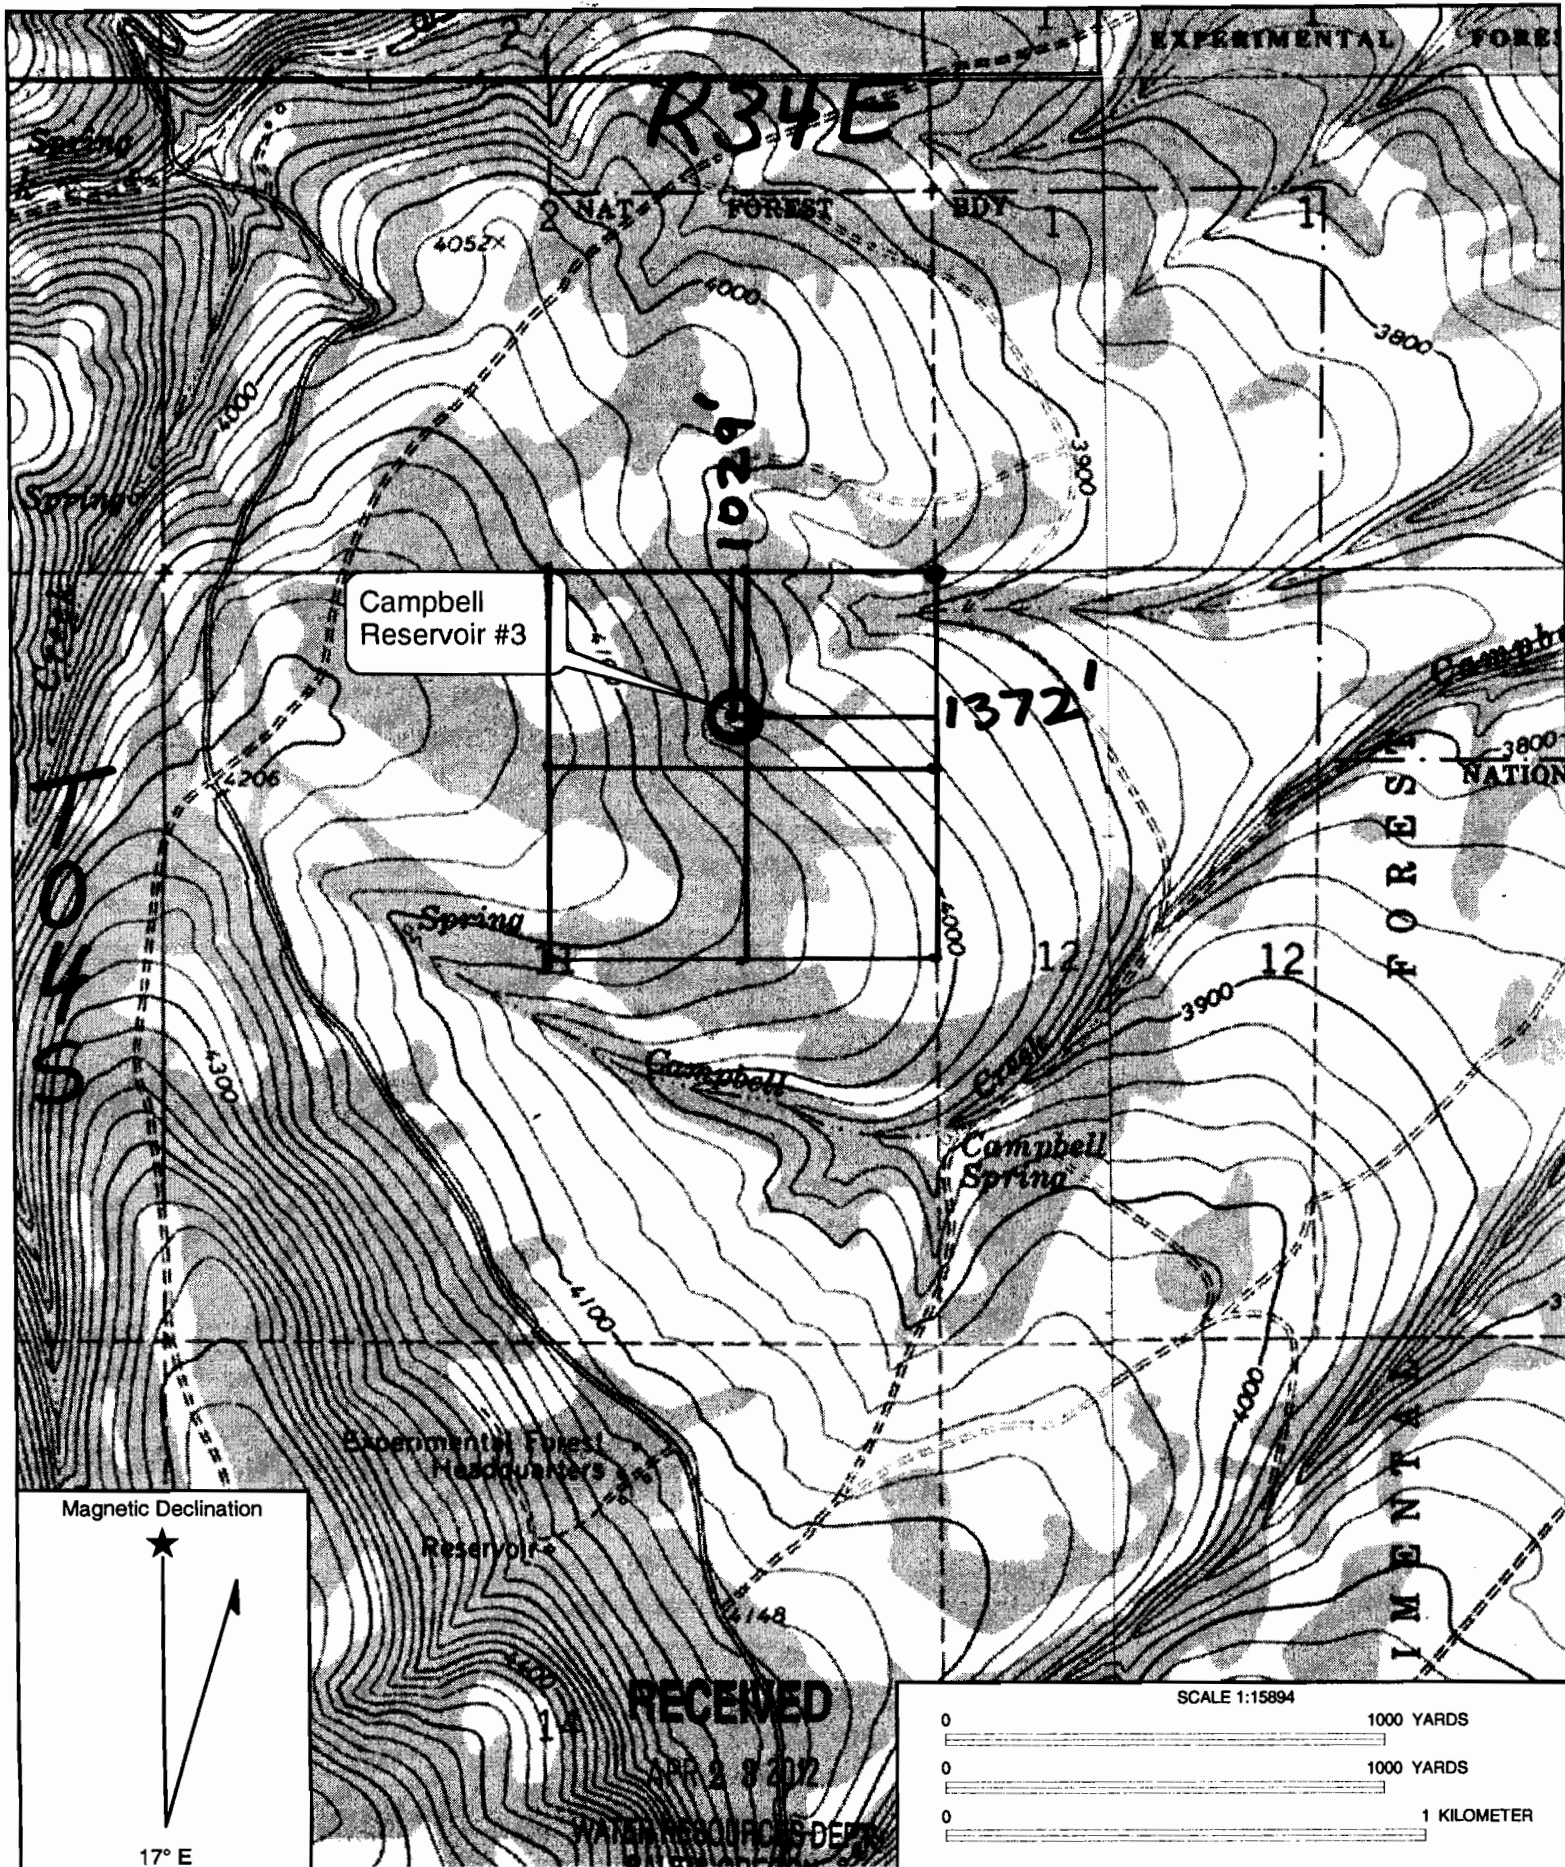

Name: SULLIVAN GULCH
Date: 2/28/2012
Scale: 1 inch equals 1325 feet

Location: 11 0381592 E 5009792 N NAD27
Caption: Campbell Reservoir #3

© Marks Center of Reservoir