
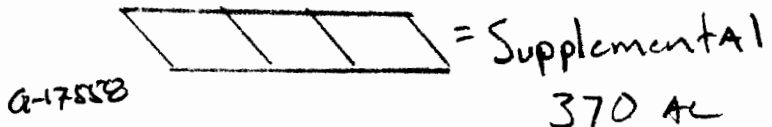


1" = 1320 Ft.

- Bath Ln
- Well # 1, 3960' N of SW corner of sec. 20, 435' E
  - Well # 2, 3960' N of SW corner of Sec. 20, 1325' E
  - x # 3 3960' N of SW corner of Sec 20, 2575' E
- Peach Rd

T 2 S R 39 E

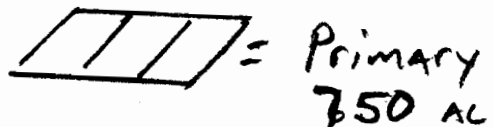

Q-1755B