


RECEIVED

MAY 3 1 2012

**WATER RESOURCES DEPT
SALEM, OREGON**

Outlet Location: 3260 feet north
& 800 feet east of SW corner of
Sec. 24, T5N, R5W.

R- 82812

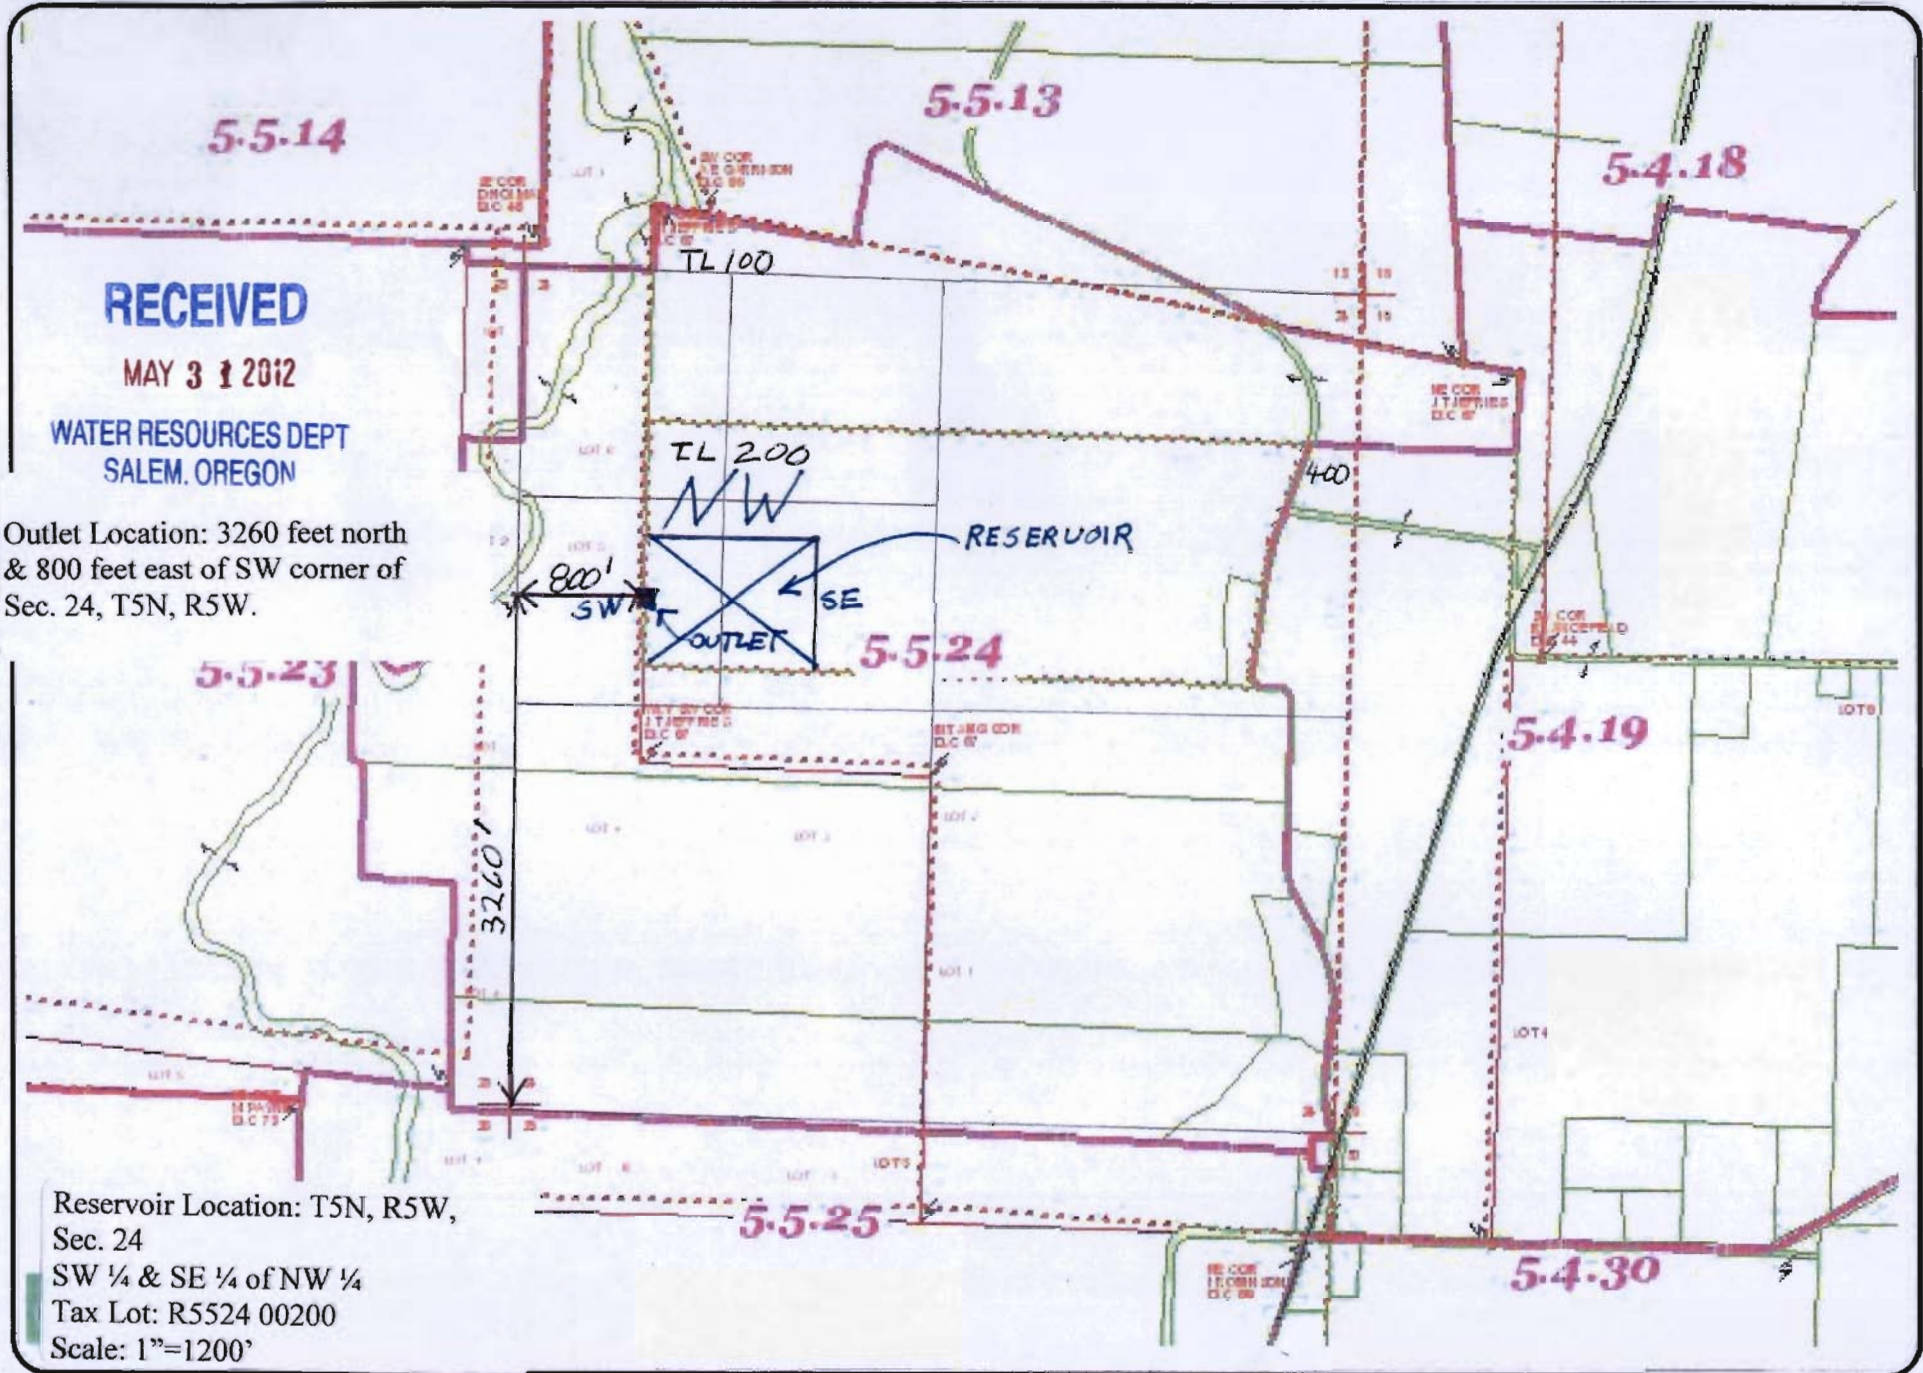

Reservoir Location: T5N, R5W,
Sec. 24
SW ¼ & SE ¼ of NW ¼
Tax Lot: R5524 00200
Scale: 1"=1200'