


Yamhill County Webmaps

[Help](#) [Disclaimer](#) [Contact Yamhill GIS](#)

Identify Sketch Tools Advanced Tools Basemap Photo Taxmap TaxMaps

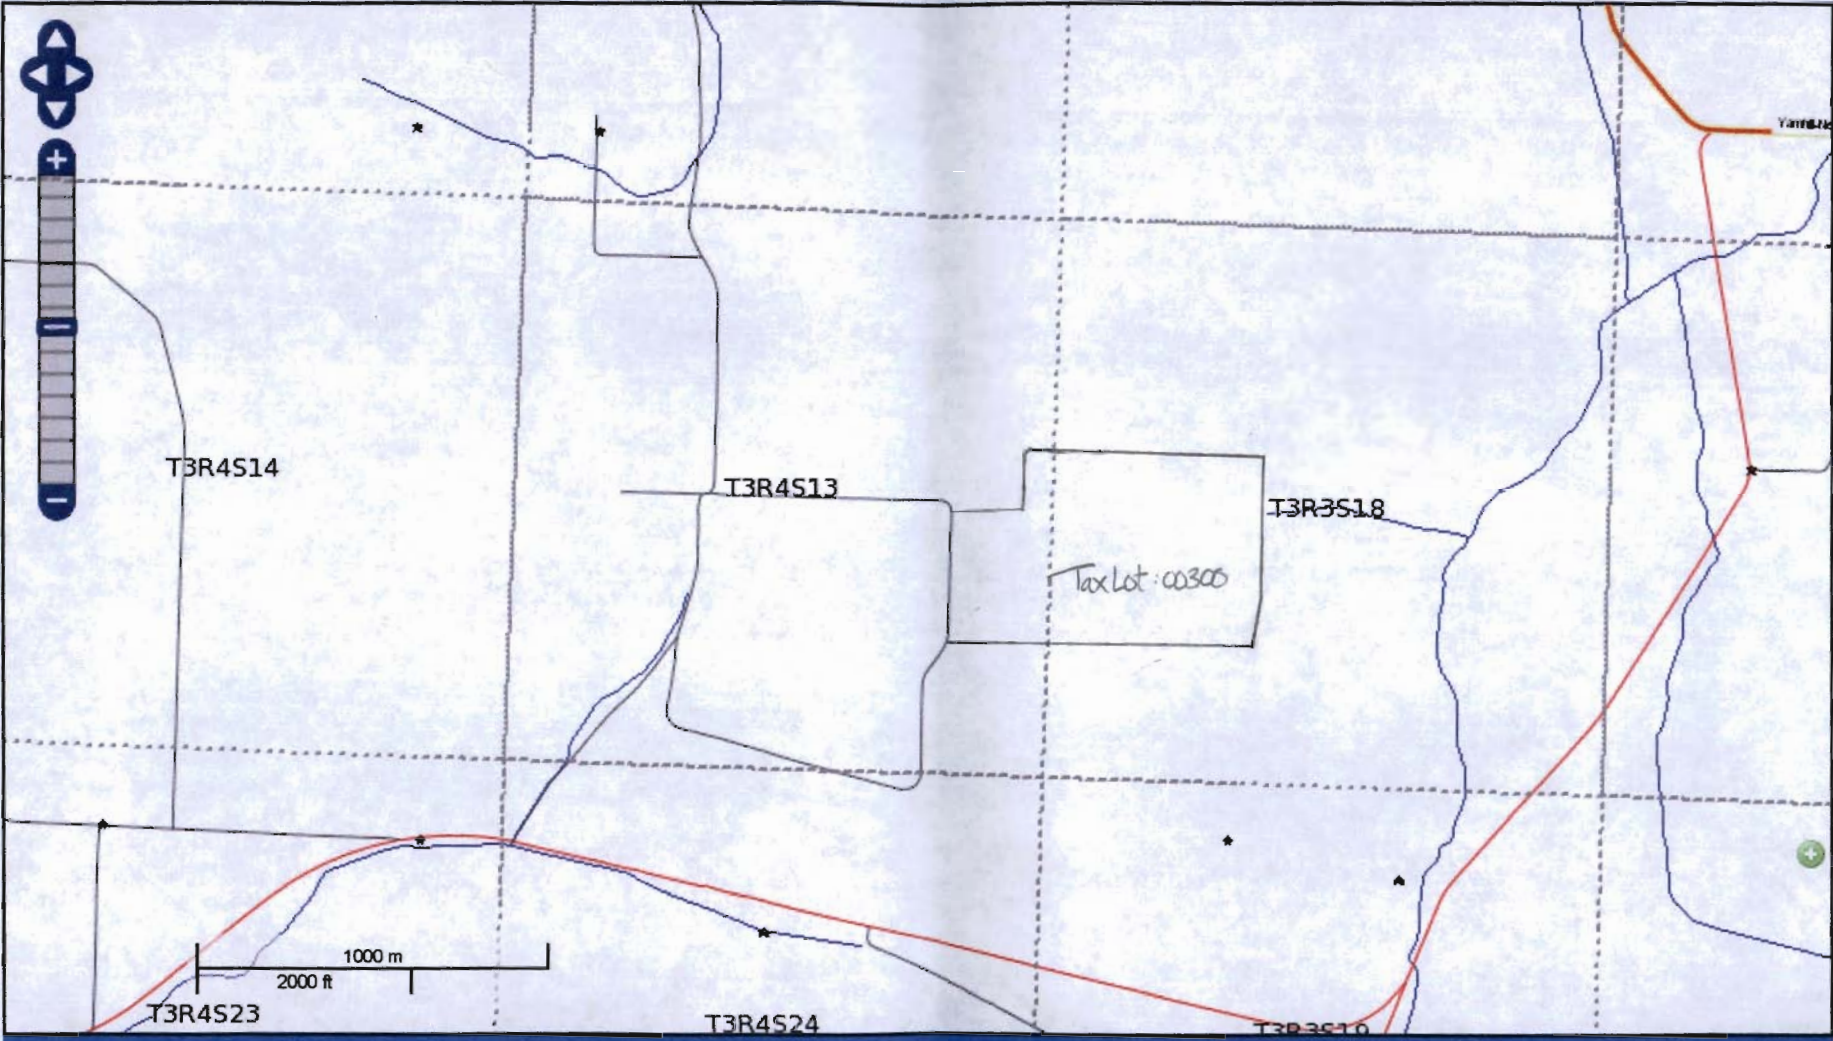

R-87814

X,Y: 7532205.26206, 613517.62025 Scale: 1:16337

RECEIVED


<< Show Tabs

JUN 07 2012

WATER RESOURCES DEPT
SALEM, OREGON



Identify Basemap Photo Taxmap **Apps**

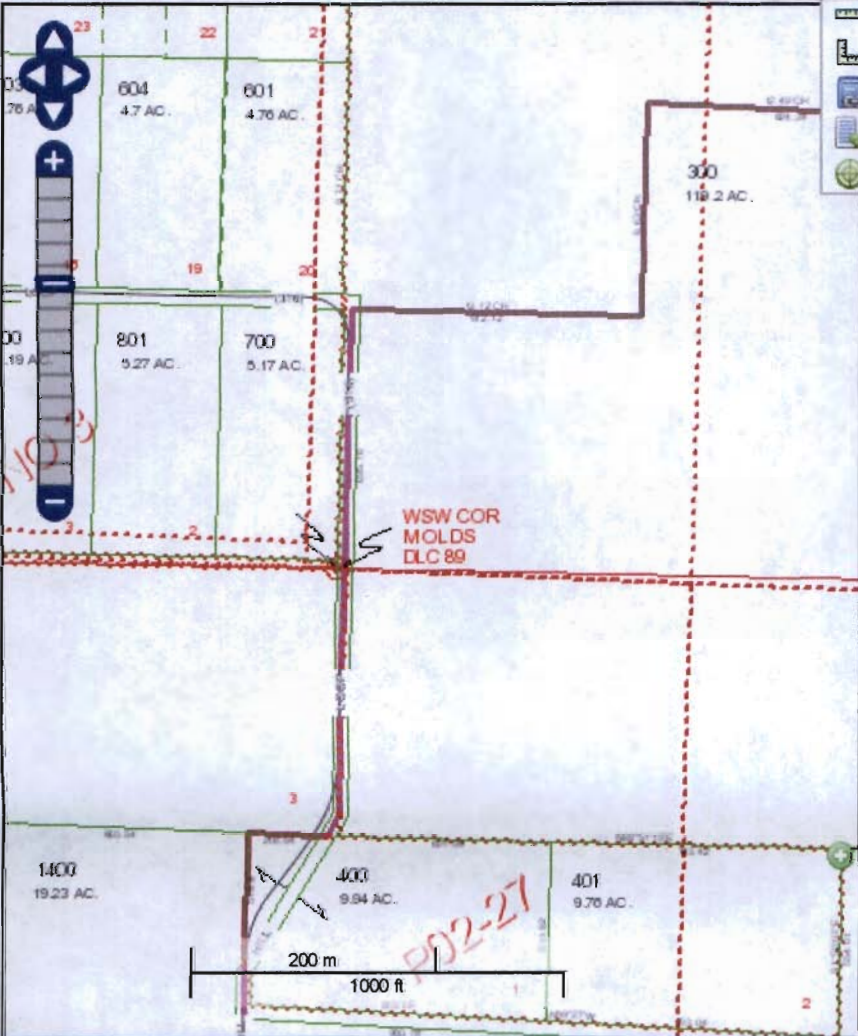

- Measure Line
- Measure Area
- Display Bookmark
- Bird's Eye and Google
- Geocode Address

results
the location you
Coordinates

Map Tax Lot

Click to See **R3318 00300**
Assessment Report:
Account Number: 73226
Image: [Map Image](#)
Map: 3.3.18
TaxLot: 00300
Owner: Resident
Owner: Resident
Owner: Resident
Mailing Add: 11645 NE FINN HILL LOOP
Mailing Add:
City State: CARLTON, OR 97111
Primary Situs: 11645 NE FINN HILL LP
Situs City: 0
Neighborhood: RYC2
Property Class: 5512

X,Y: 7531313.00184, 609539.92399 Scale: 1:4635

>> Hide Tabs

RECEIVED

JUN 07 2012

R-87814

WATER RESOURCES DEPT
SALEM, OREGON


SECTION

1" = 1320

TOWNSHIP 3^{South}, RANGE 3^{West}, W. M.

Section 18

North Tax Lot 300

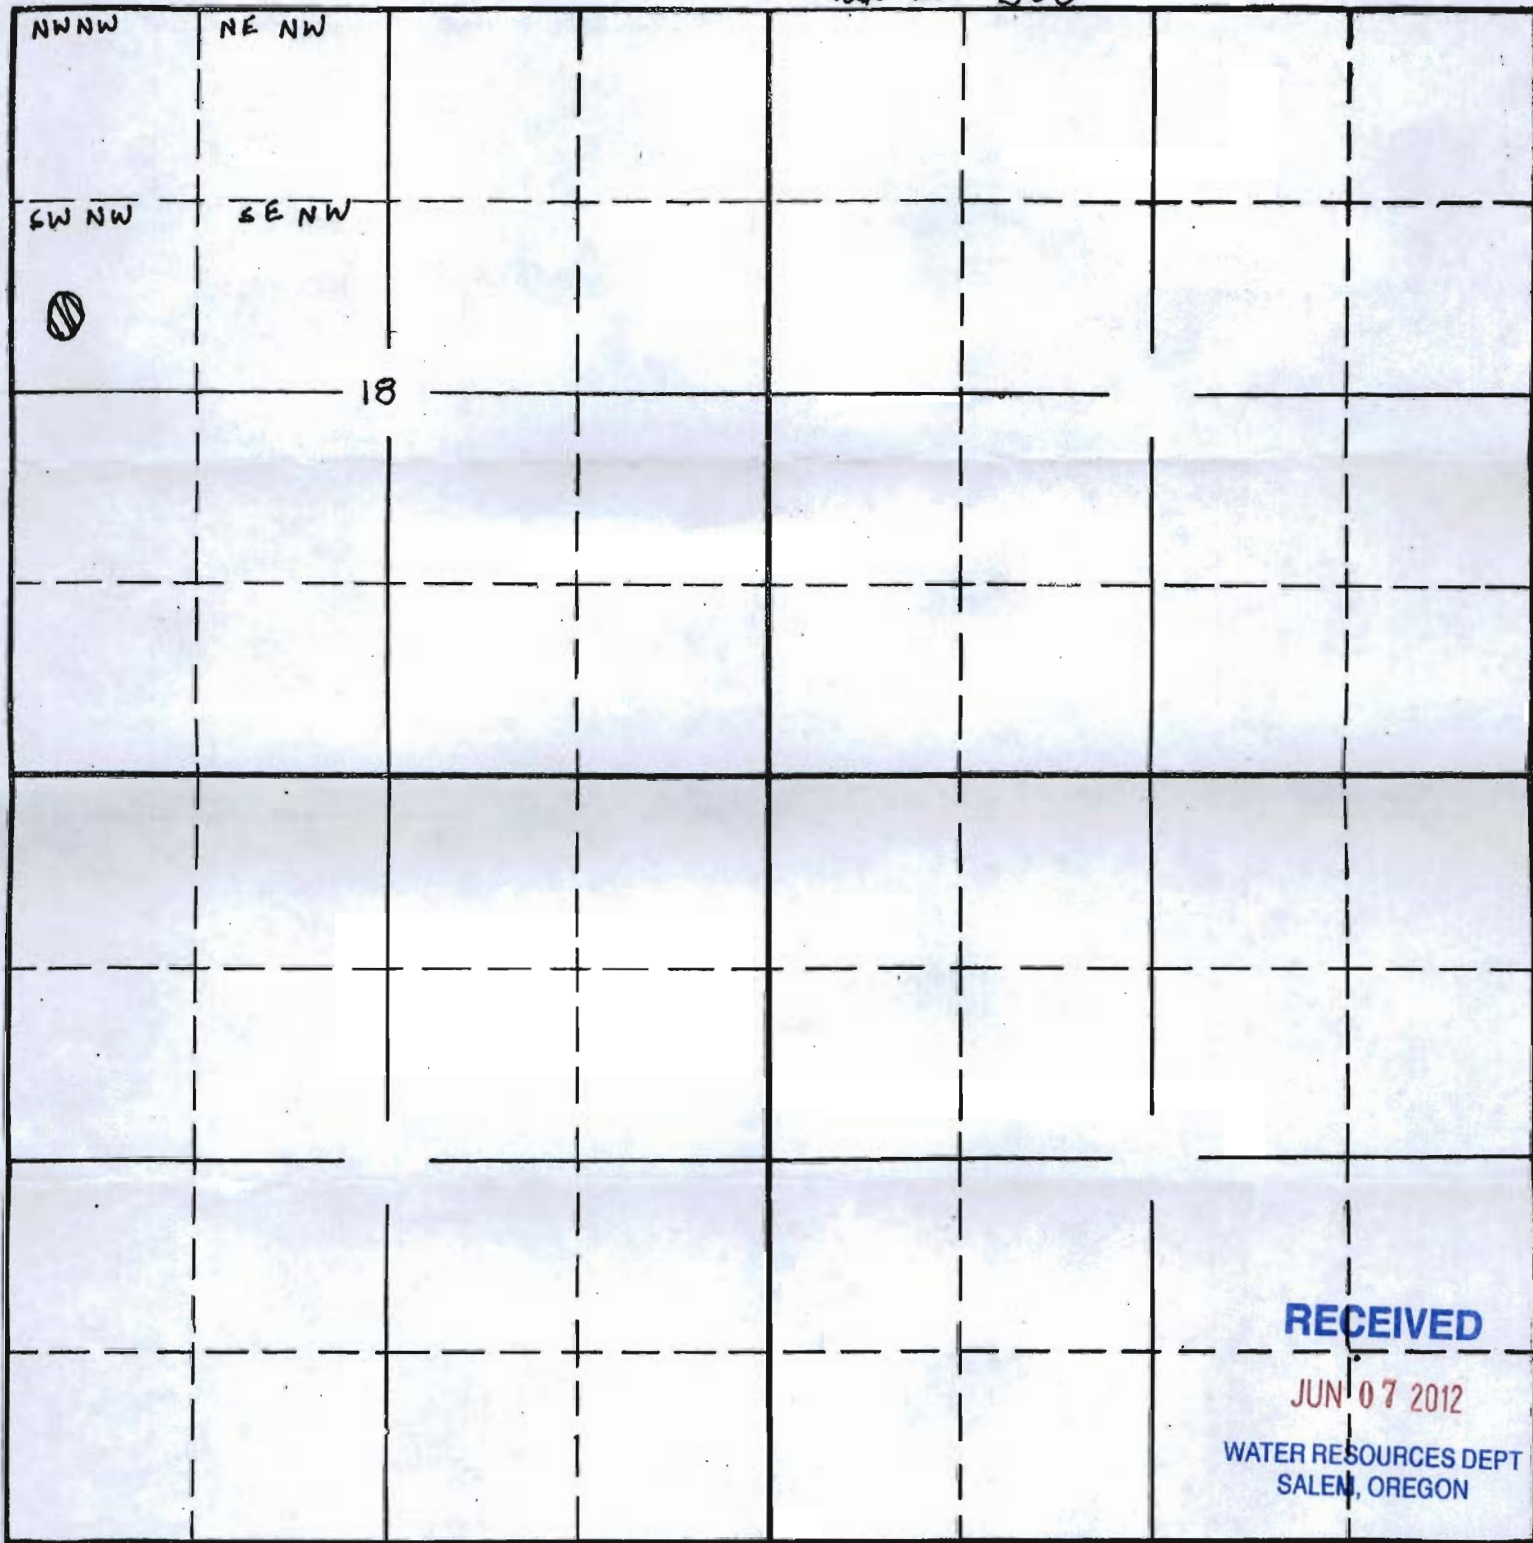


South

600 feet East and 515 feet North
from W¹/₄ of Section 18

R-87814

APPLICATION No.
PERMIT No.

↑ North (Spacie/Mahon)
6/2/12

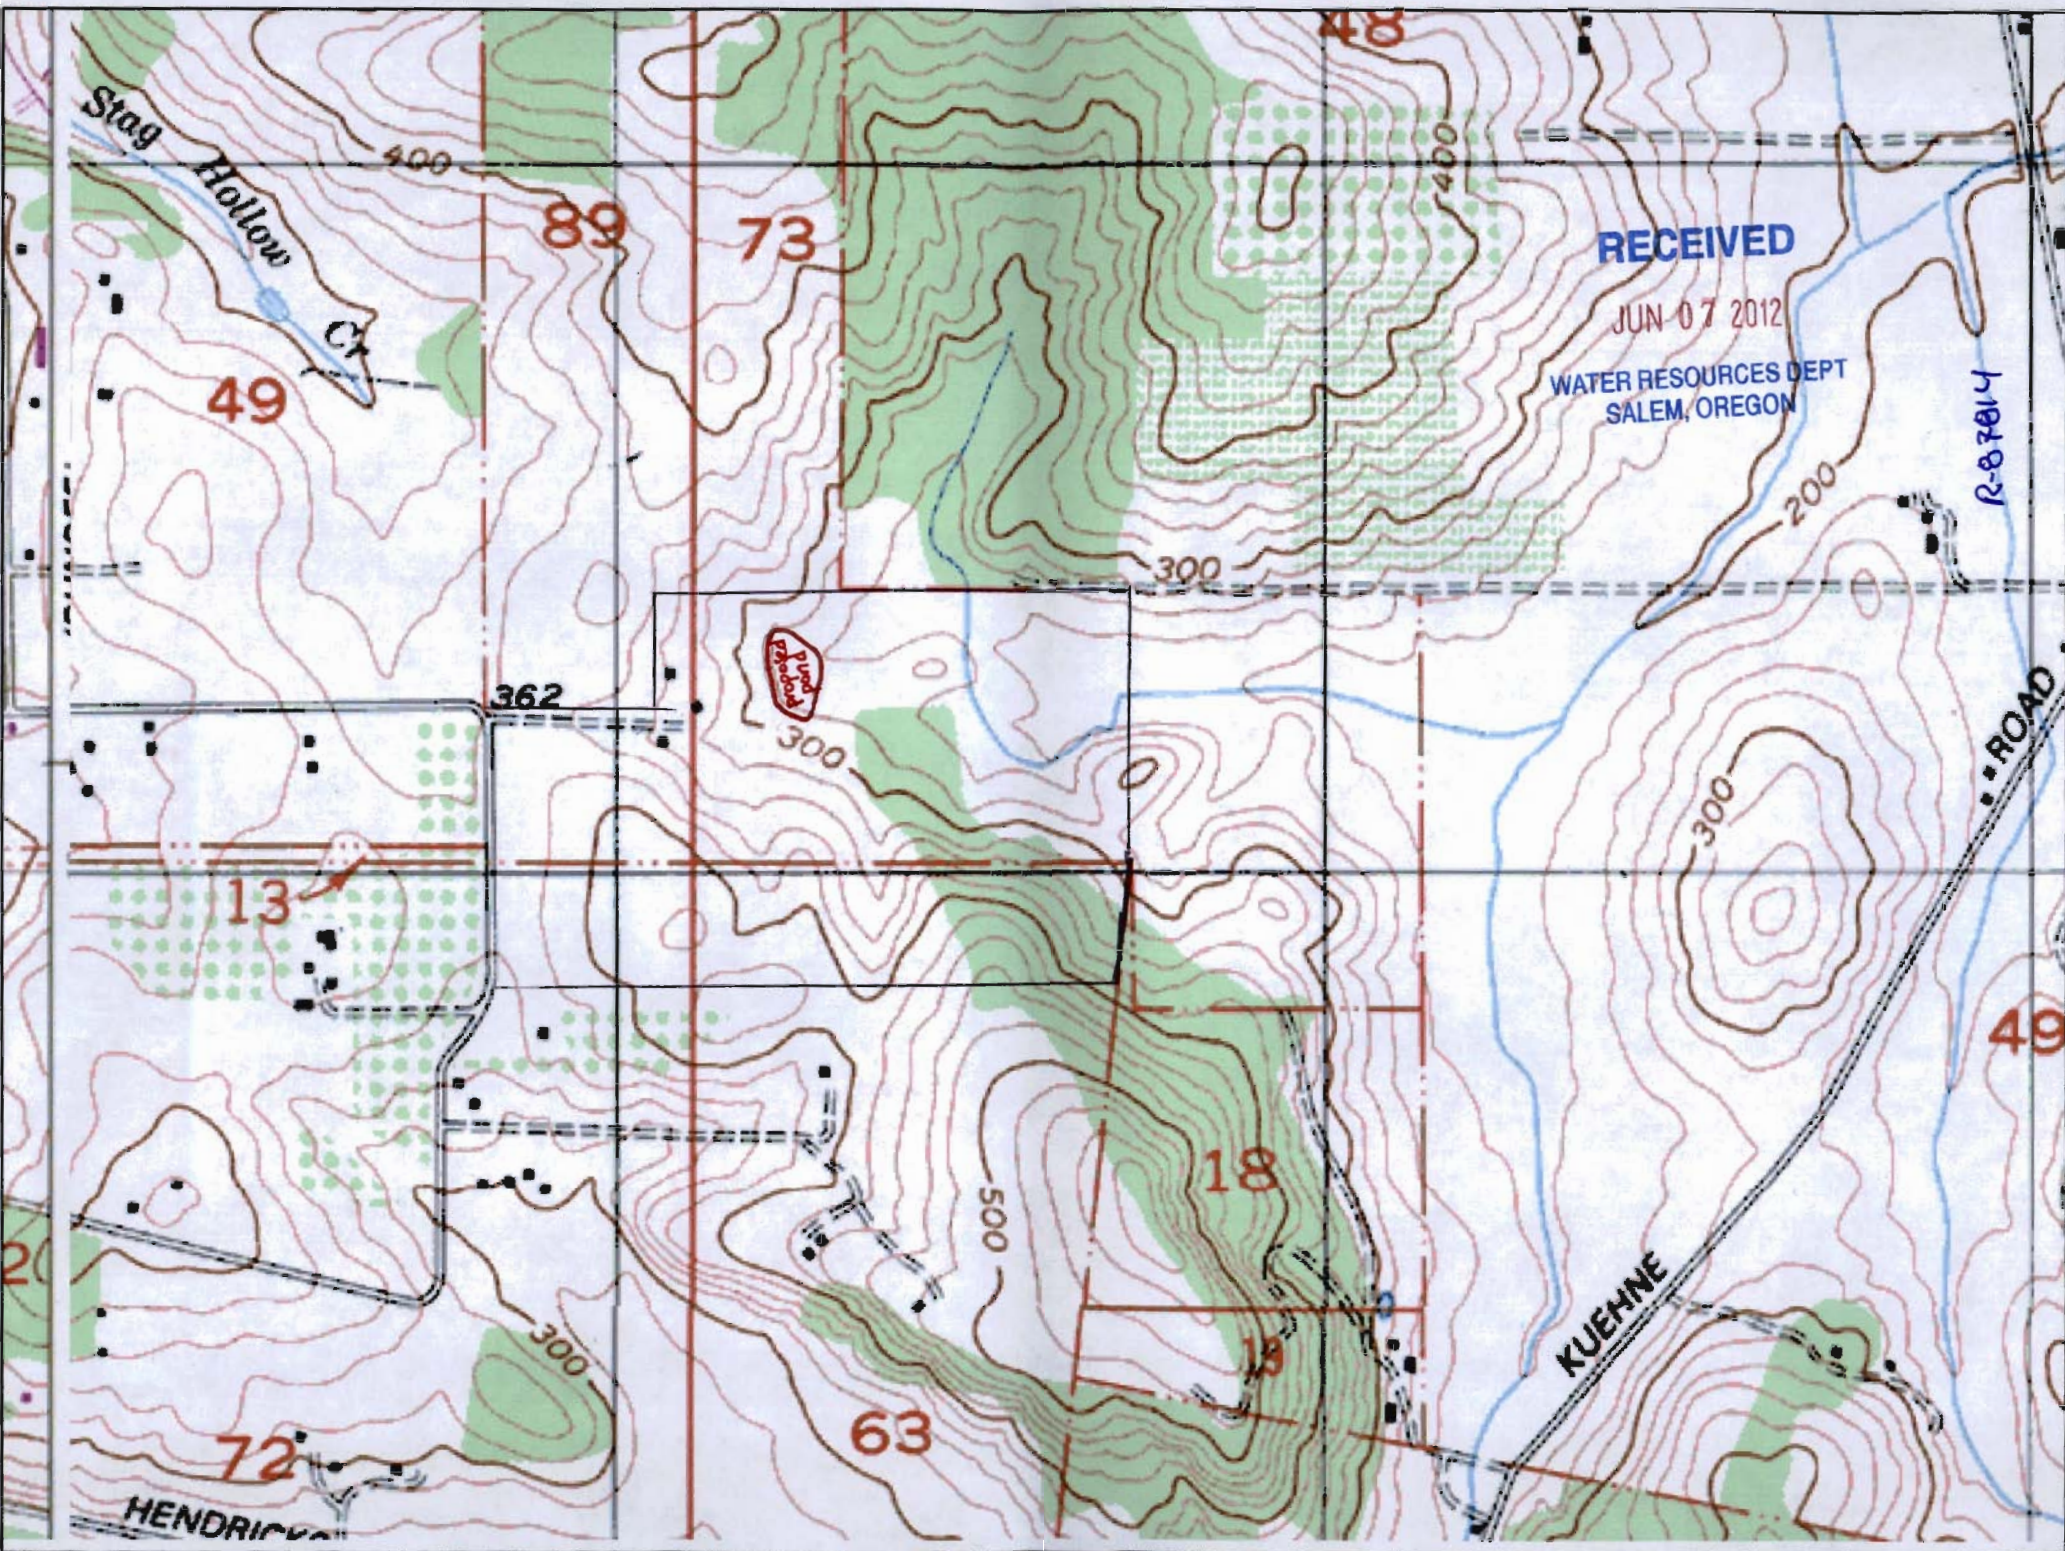

T: 33 R: 4W



Oregon Water Resources Department

725 Summer St NE, Salem, OR 97301

(503)986-0900

RECEIVED

JUN 07 2012

Oregon Water Rights

**WATER RESOURCES DEPT
SALEM, OREGON**



Water Rights By Type

Points of Diversion	Places of Use
Points of Diversion	Storage water
Points of Diversion	Surface water
Points of Diversion	Ground water

Water Rights By Use (Places of Use)

Recreation	Miscellaneous	Mining	Municipal
Fish	Agriculture	Power	Points of Diversion
Wildlife	Livestock	Commercial	Colors vary with use
Instream	Irrigation	Domestic	

R-87814