



NE¹/₄, NE¹/₄ & SE¹/₄, NE¹/₄
 SECTION 22
 TOWNSHIP 13 SOUTH, RANGE 1 EAST, W. M.

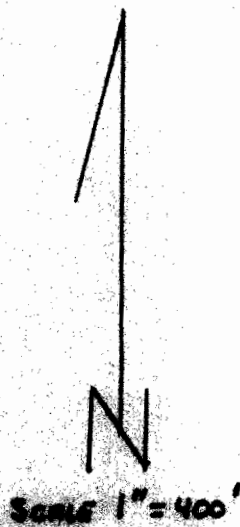

1. Big Pond - Located 1208 ft. South and 648 ft. West
2. Catfish pond - Located 1365 ft. South and 268 ft. West
3. Trout Pond - Located 822 ft. South and 428 ft. West
4. Dike Pond - Located 1073 ft. South and 796 ft. West
5. Orchard Pond - Located 1064 ft. South and 328 ft. West

All from the Northeast Section Corner,
 Section 22

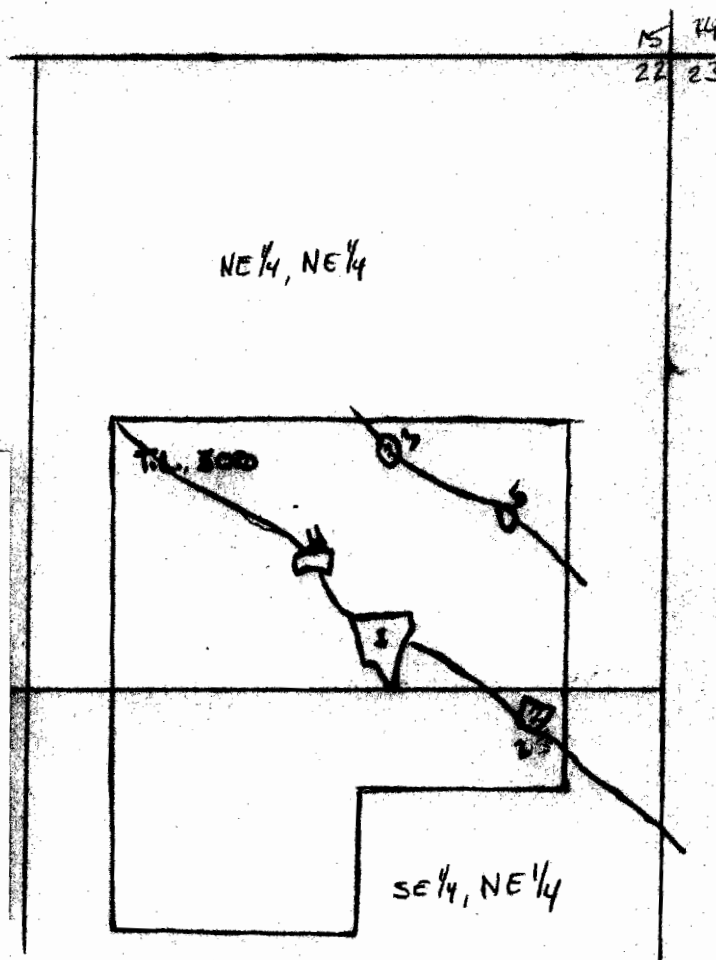

R07015




Oregon Water Resources Department

725 Summer St NE, Salem, OR 97301

(503)986-0900

Oregon Water Rights

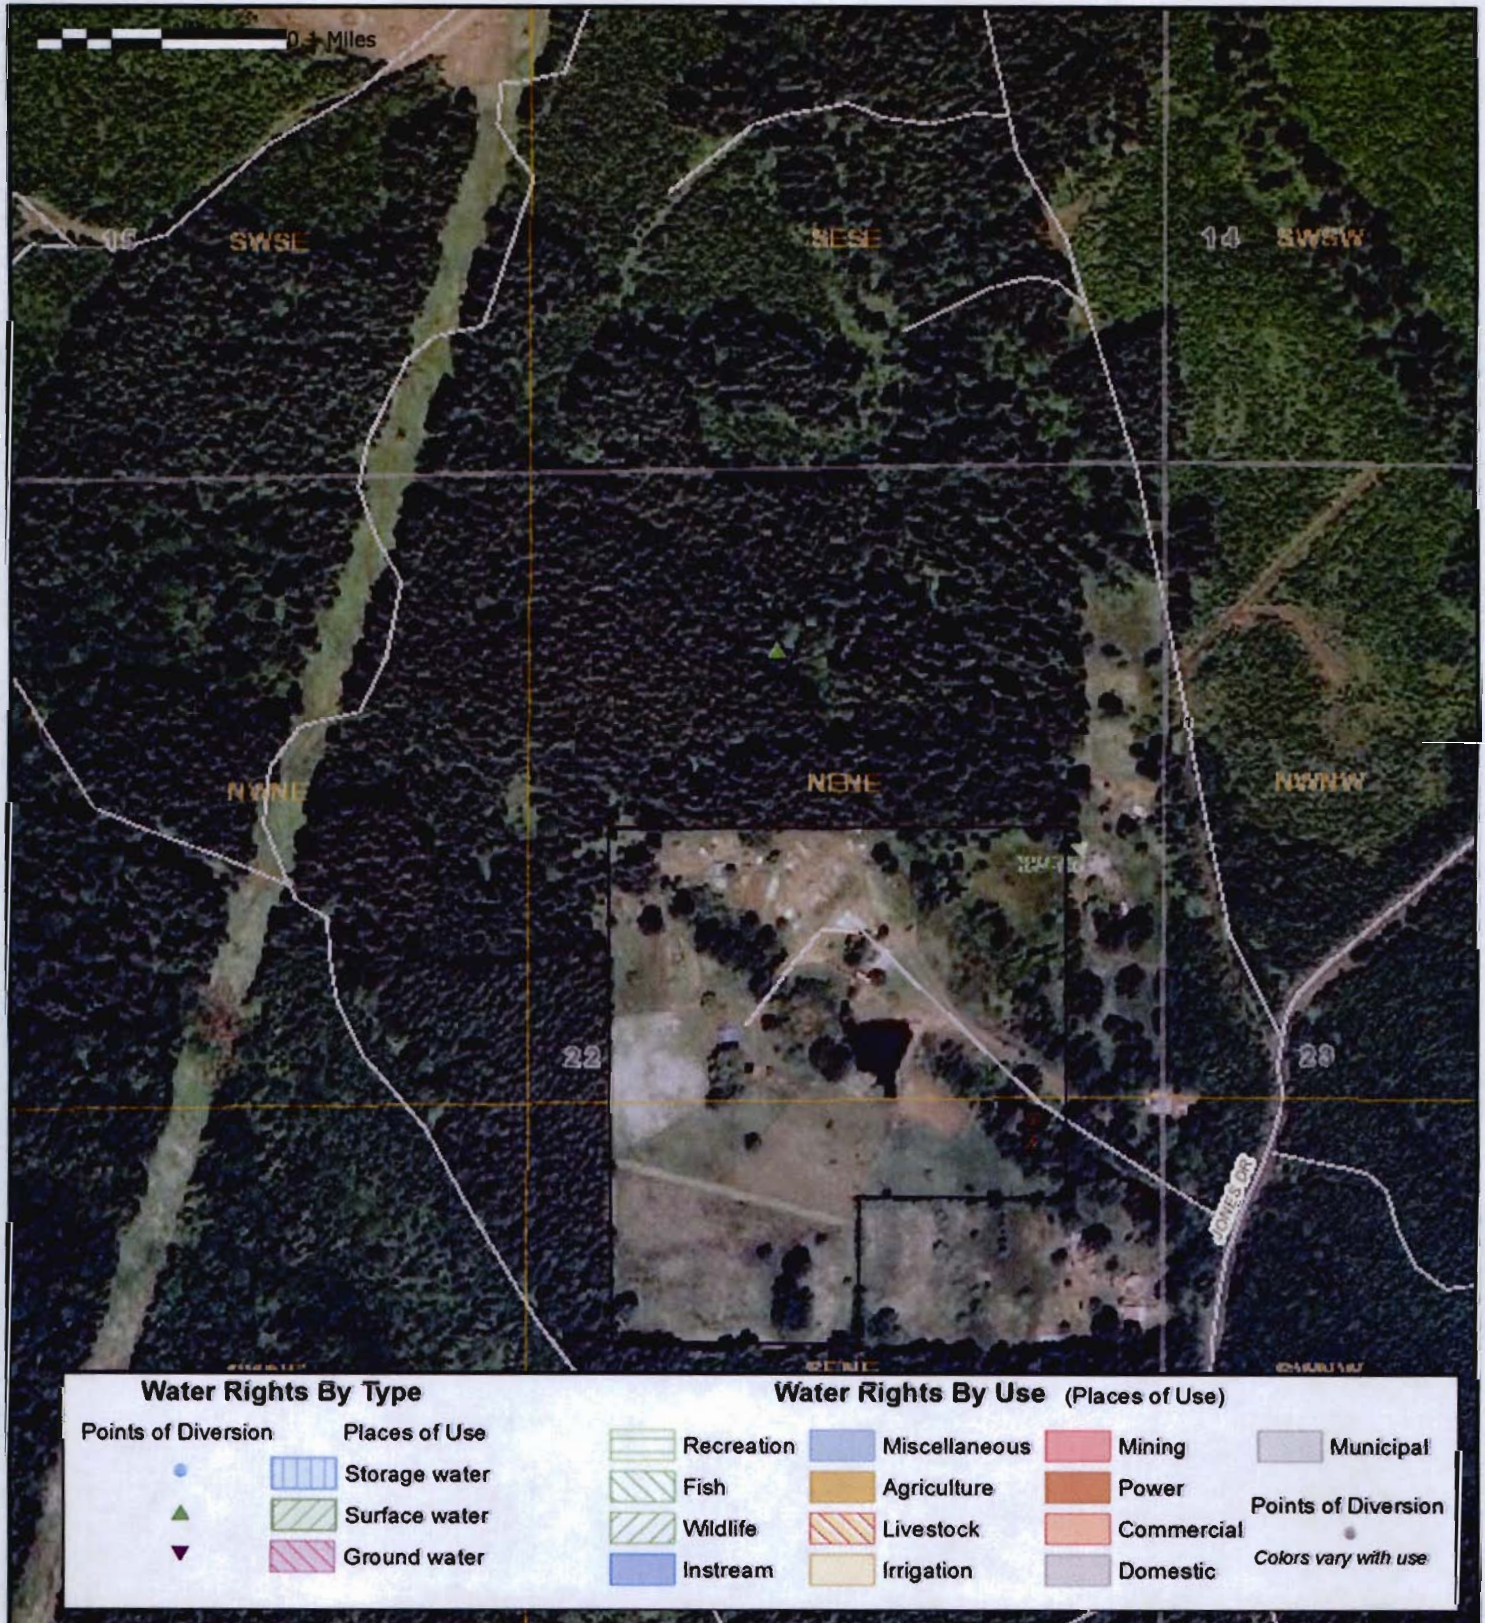

12-87815

THIS MAP WAS PREPARED FOR
ASSESSMENT PURPOSES ONLY

SEC. 22 T. 13S. R. 01E. W.M.
LINN COUNTY, OREGON
1" = 400'

13 1E 22

SEE MAP 13 1E

55-15

SEE MAP 13 1E 21

SEE MAP
13 1E 22C

PORTER DAM LINE

55-13

SEE MAP 13 1E

SEE MAP 13 1E

13 1E 22

04/21/06.14:39:54.Fri


2-07015

13 1E 22



Map printed
from Linn Co
Assessors office
May 3, 2012

Note:
Dimensions
given N, S, E, W
correspond with
Assessors Map
and not true
North

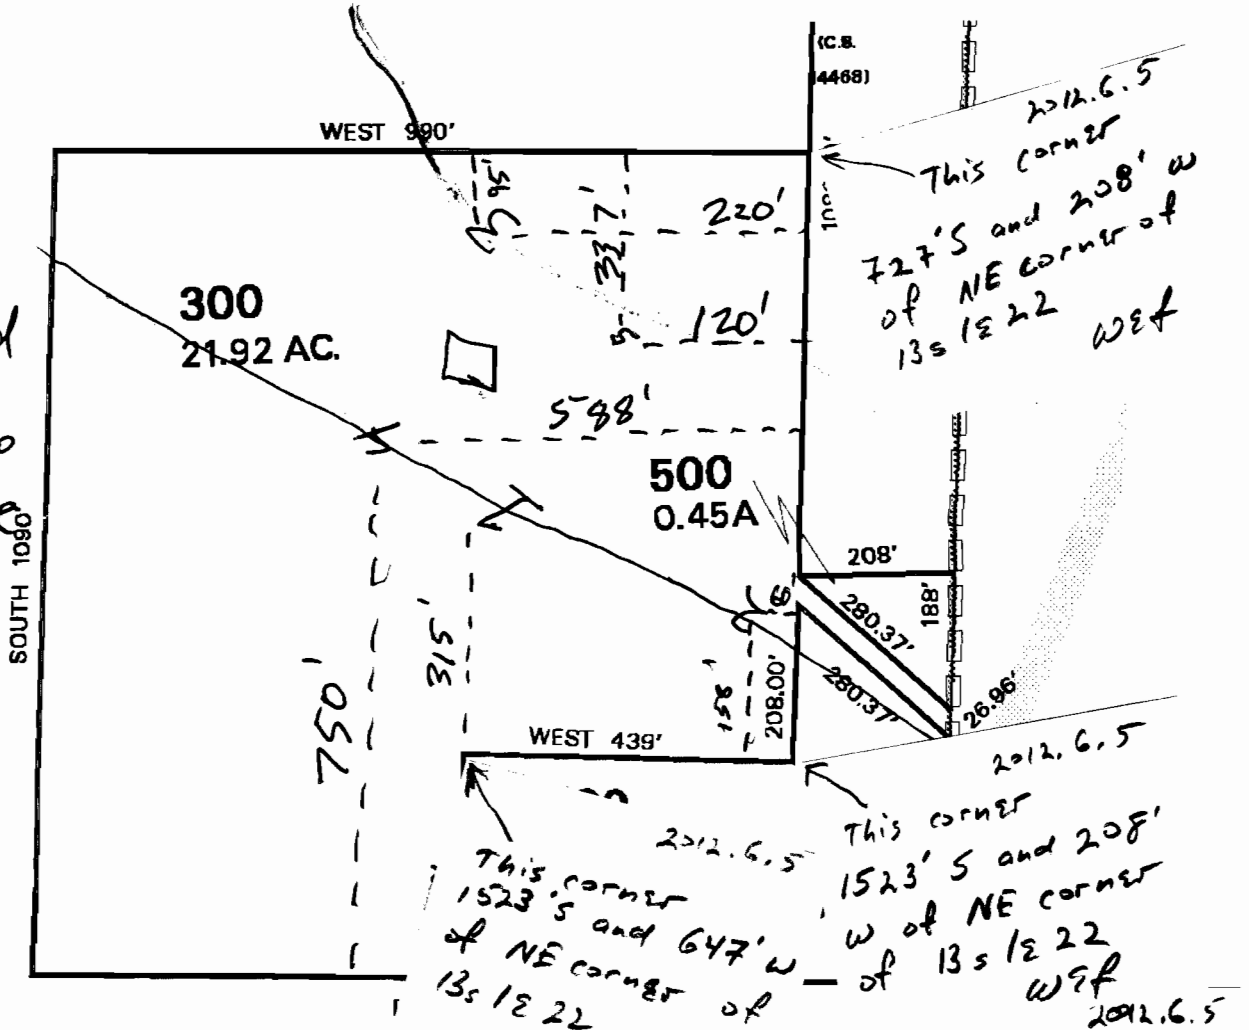

- 3 Trout Pond COP, 95' from W' line, 220' from N' line
- 4 Dike Pond COP, 588' from N' line, 750' from E. line
- 5 Orchard Pond, 337' from W' line, 120' from N' line

RECEIVED

MAY 08 2012

WATER RESOURCES DEPT
SALEM, OREGON

RECEIVED

MAY 23 2012

WATER RESOURCES DEPT
SALEM, OREGON


R-87015

13 1E 22



Map printed
from Linn Co
Assessors office
May 3, 2012

Note:
Dimensions
given N, S, E, W
correspond with
Assessors map
and not true
North

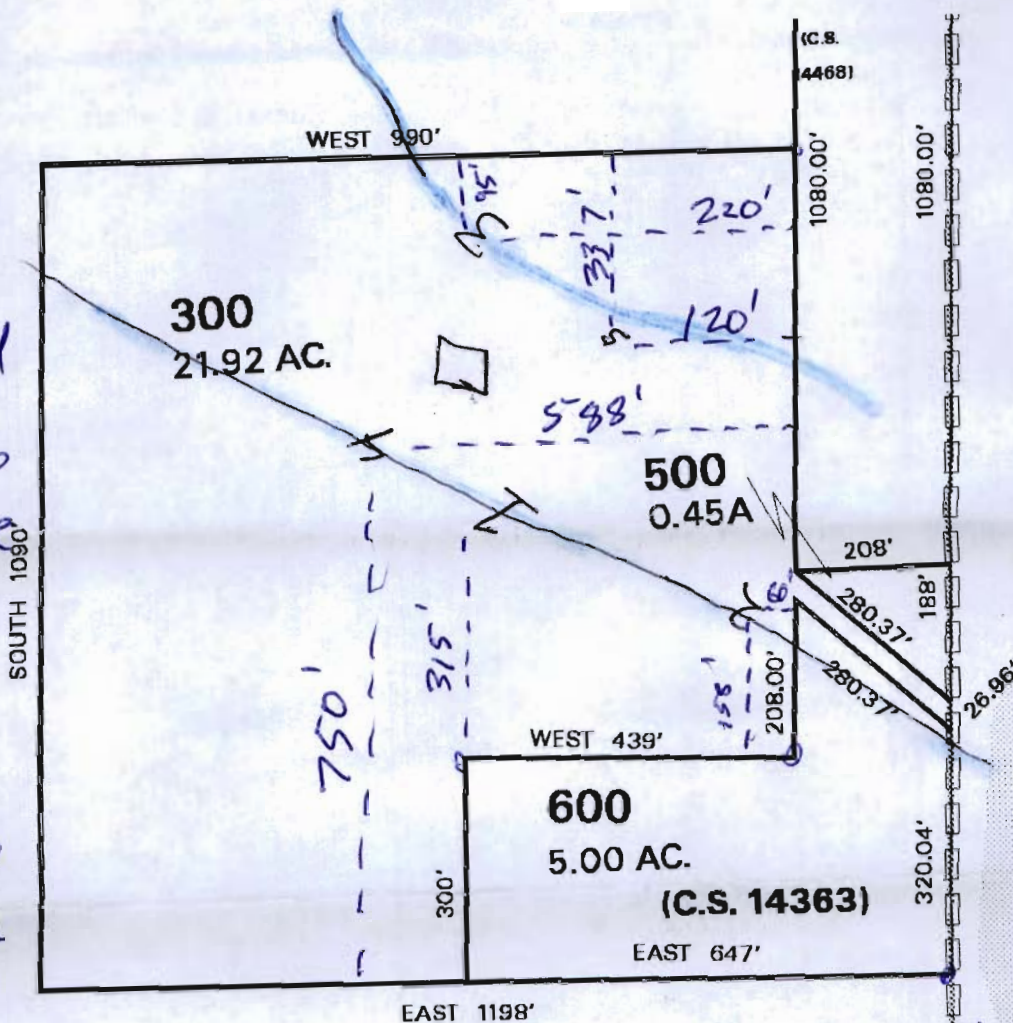

- 1 Big Pond - Center of Pond, 440' from N' line, 315' from SW corner of 600 lot
- 2 Catfish Pond - COP, 60' from N' line, 158' from 600
- 3 Trout Pond COP, 95' from W' line, 220' from N' line
- 4 Dike Pond COP, 588' from N' line, 750' from E. line
- 5 Orchard Ponds, 337' from W' line, 120' from N' line

RECEIVED

MAY 08 2012

WATER RESOURCES DEPT
SALEM, OREGON

RECEIVED

MAY 23 2012

WATER RESOURCES DEPT
SALEM, OREGON

R-87015