



T. 15 S., R. 15 E., W.M.

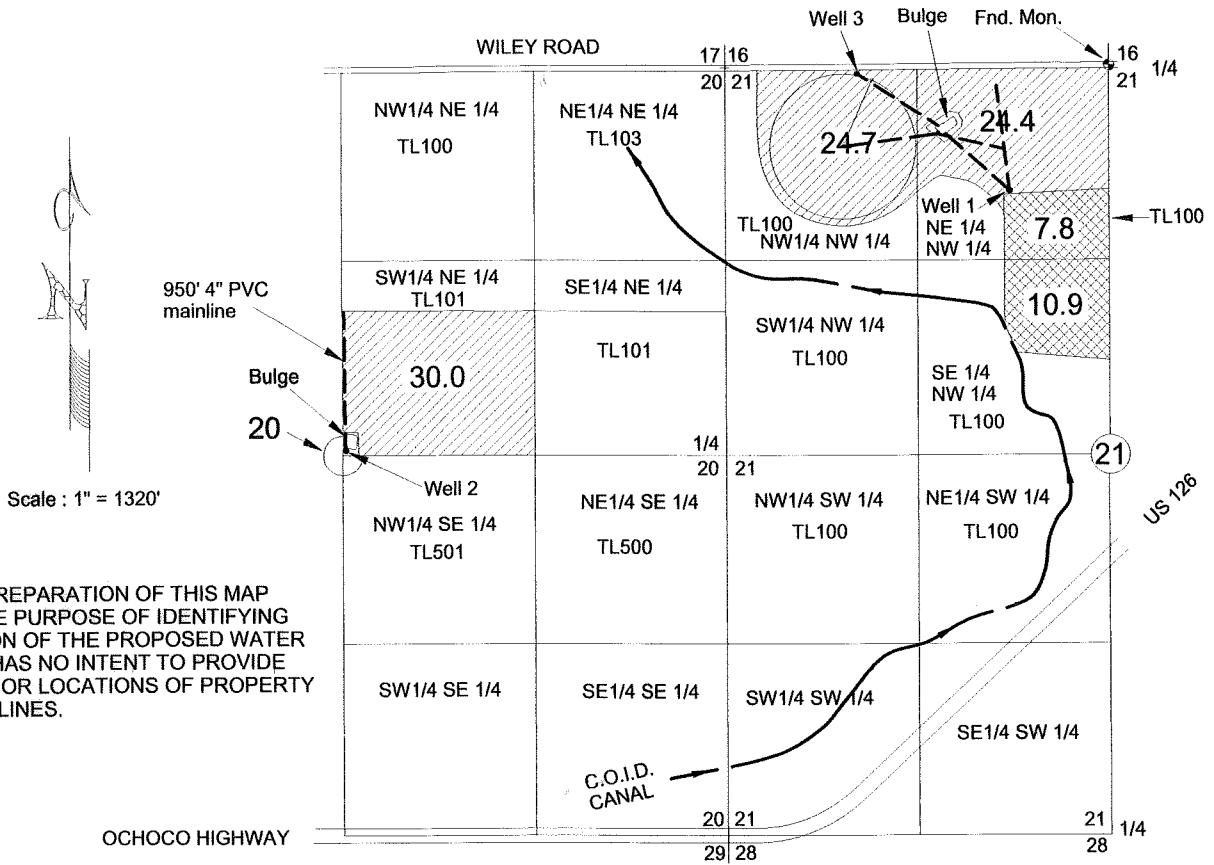

NOTE: THE PREPARATION OF THIS MAP WAS FOR THE PURPOSE OF IDENTIFYING THE LOCATION OF THE PROPOSED WATER RIGHT, AND HAS NO INTENT TO PROVIDE DIMENSIONS OR LOCATIONS OF PROPERTY OWNERSHIP LINES.

Graphic Well Ties to Found Monuments (Not To Scale)

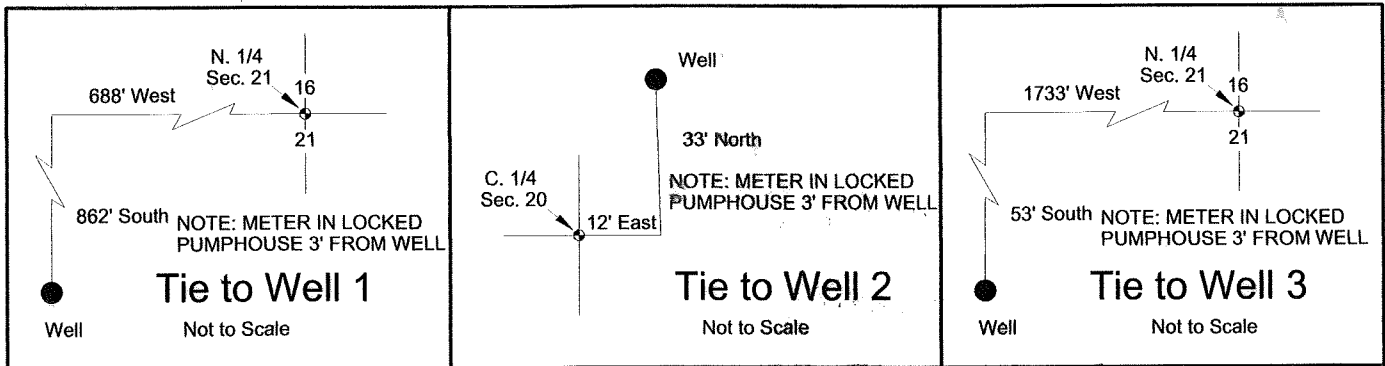


- LEGEND -

-  Primary Acreage irrigated under permit # G-11786 (79.1 Acres)
-  Supplemental Acreage claimed under permit # G-11786 (79.1 Acres)
Supplemental to Cert. #83571 And #76714 (Central Ore. Irrigation Dist.)
-  Buried Mainline
-  Buried Mainline with risers

Final Proof Map
Permit # G-11786


for
Joe W. Waibel
by

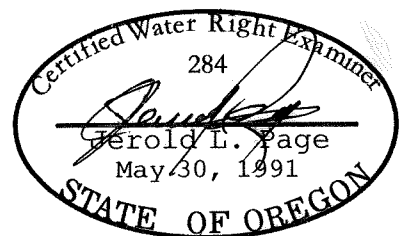

RENEW 12-31-10


Application # G-12552

T. 15 S., R. 15 E., W.M.

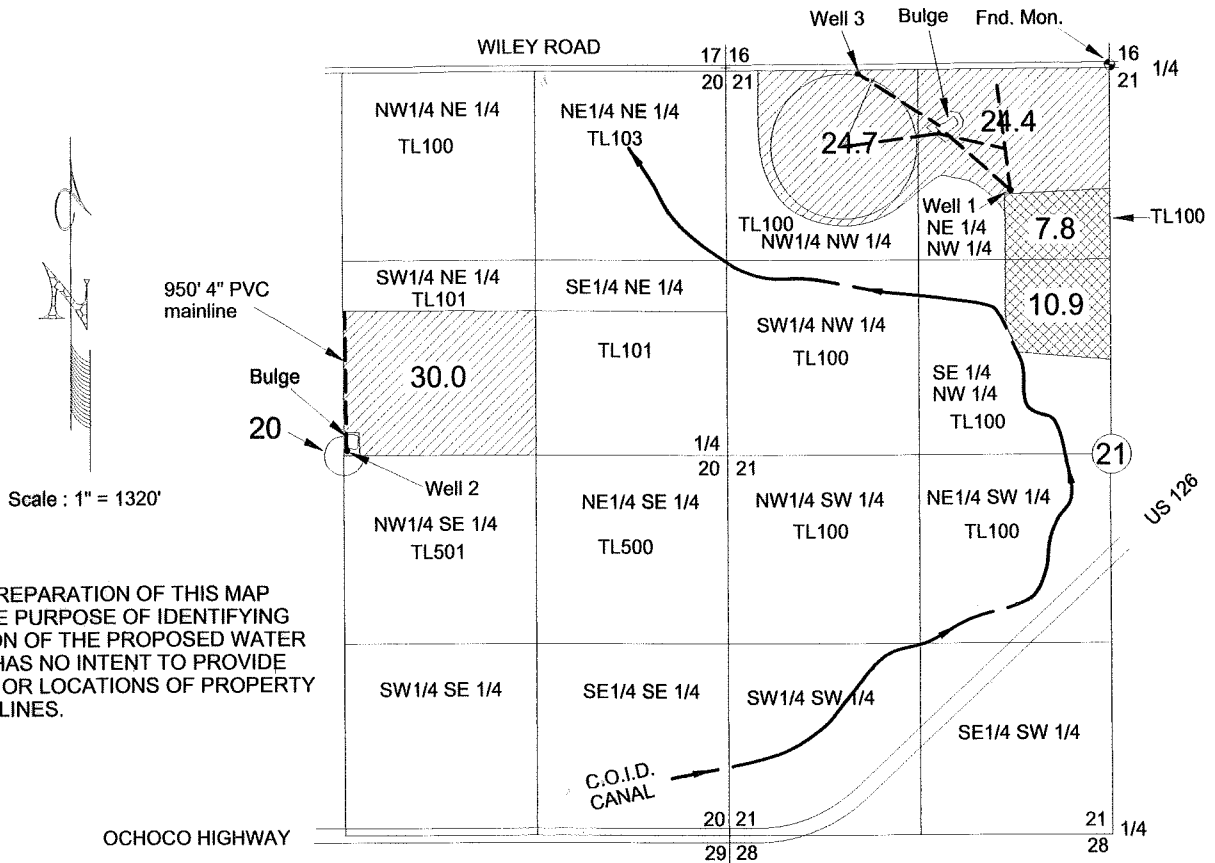

NOTE: THE PREPARATION OF THIS MAP WAS FOR THE PURPOSE OF IDENTIFYING THE LOCATION OF THE PROPOSED WATER RIGHT, AND HAS NO INTENT TO PROVIDE DIMENSIONS OR LOCATIONS OF PROPERTY OWNERSHIP LINES.

Graphic Well Ties to Found Monuments (Not To Scale)

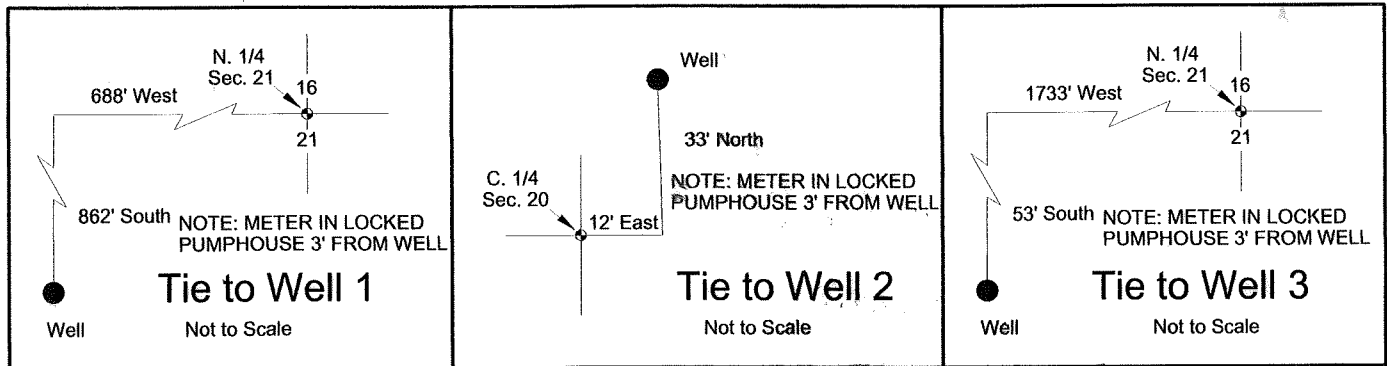


- LEGEND -

- Primary Acreage irrigated under permit # G-11786 (79.1 Acres)
- Supplemental Acreage claimed under permit # G-11786 (79.1 Acres) Supplemental to Cert. #83571 And #76714 (Central Ore. Irrigation Dist.)
- Buried Mainline
- Buried Mainline with risers

Final Proof Map
Permit # G-11786

for
Joe W. Waibel
by

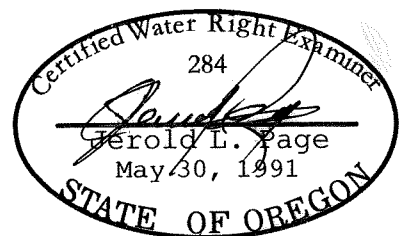

RENEW 12-31-10

Application # G-12552

WATER RESOURCES DEPT
SALEM, OR

RECEIVED

RECEIVED

OCT 01 2010