

NE 1/4 NW 1/4 17.5 acres


William R Pelletier
File # G-17518

T. 5N., R. 29E, Sec. 31, W.M.

RECEIVED

JUN 25 2012

WATER RESOURCES DEPT
SALEM, OREGON

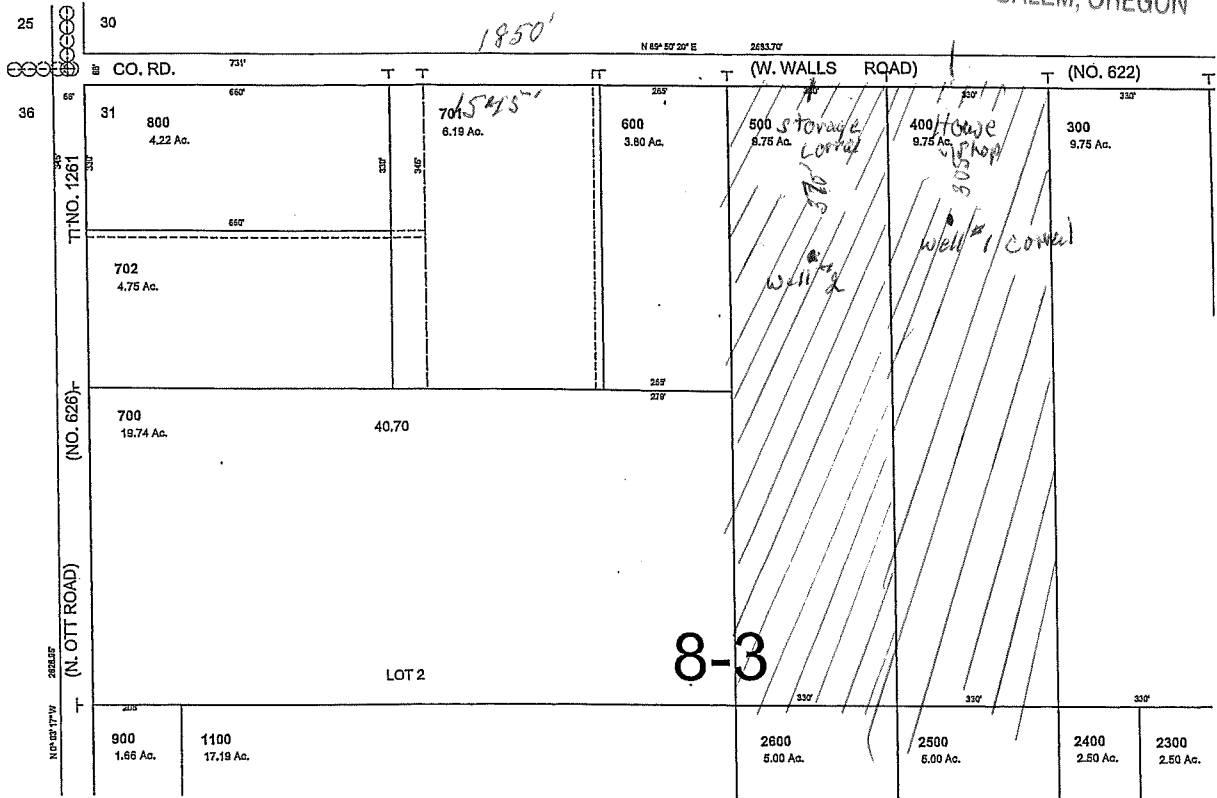

Tax Lots 400 & 500 (NENW)

Legal Descriptions

Scale 1" = 400'

Well # 1 (N. 45. 87806/W -119.23750)

UMAT 3764: 5N/29E-31 NE NW,
305' S, 1850' E from NW cor Sec 31

William R Pelletier
32184 W. Walls Rd
Hermiston, Or 97838

Well # 2 (N. 45.87778/ W -119.23875)

UMAT 57016: 5N/29E-31 NE NW,
370' S, 1545' E from NW cor Sec 31