


APPLICATION MAP IN THE NAME OF Dennis & Pamela Amsbaugh

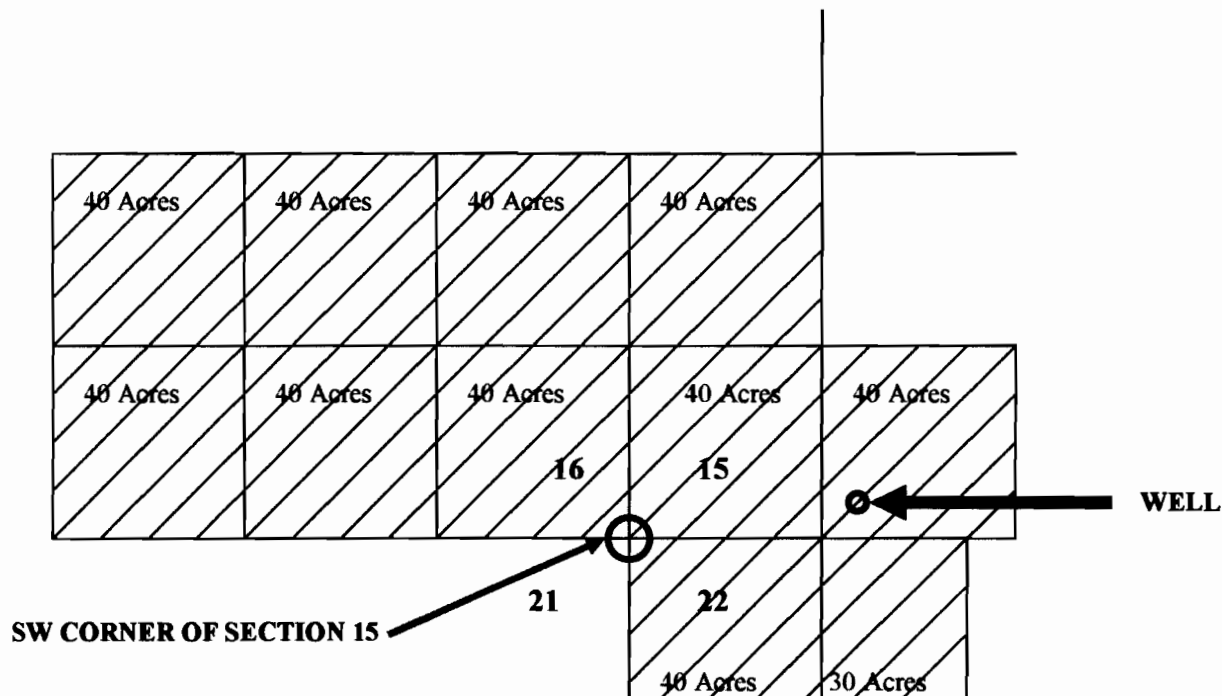

WELL IS LOCATED 130 FT NORTH AND 67 FT EAST OF THE SE SW CORNER OF SECTION 15, T40S R20 EWM.

IN TWP 40 S, R 20 E.W.M :

SECTION 15: SW 1/4 SW 1/4

SECTION 16: NE 1/4 SW 1/4, NW 1/4 SW 1/4, SW 1/4 SW 1/4, SE 1/4 SW 1/4, NE 1/4 SE 1/4, NW 1/4 SE 1/4, SW 1/4 SE 1/4, SE 1/4 SE 1/4.

SECTION 21: NE 1/4 NE 1/4

SECTION 22: W 1/2 NW 1/4 NW 1/4; W 1/2 E 1/2 NW 1/4 NW 1/4

430 ACRES TOTAL



N

SCALE: 1 INCH = 440 FEET

TAX LOTS 3200, 3300, 3400, 3500

RECEIVED BY OWRD

JUL 23 2012

SALEM, OR


G-17572

THIS MAP WAS PREPARED FOR
ASSESSMENT PURPOSE ONLY

0 1,000 2,000 4,000 Feet

T.40S. R.20E. W.M.
LAKE COUNTY
1" = 2000'

SEE MAP 39S 20E

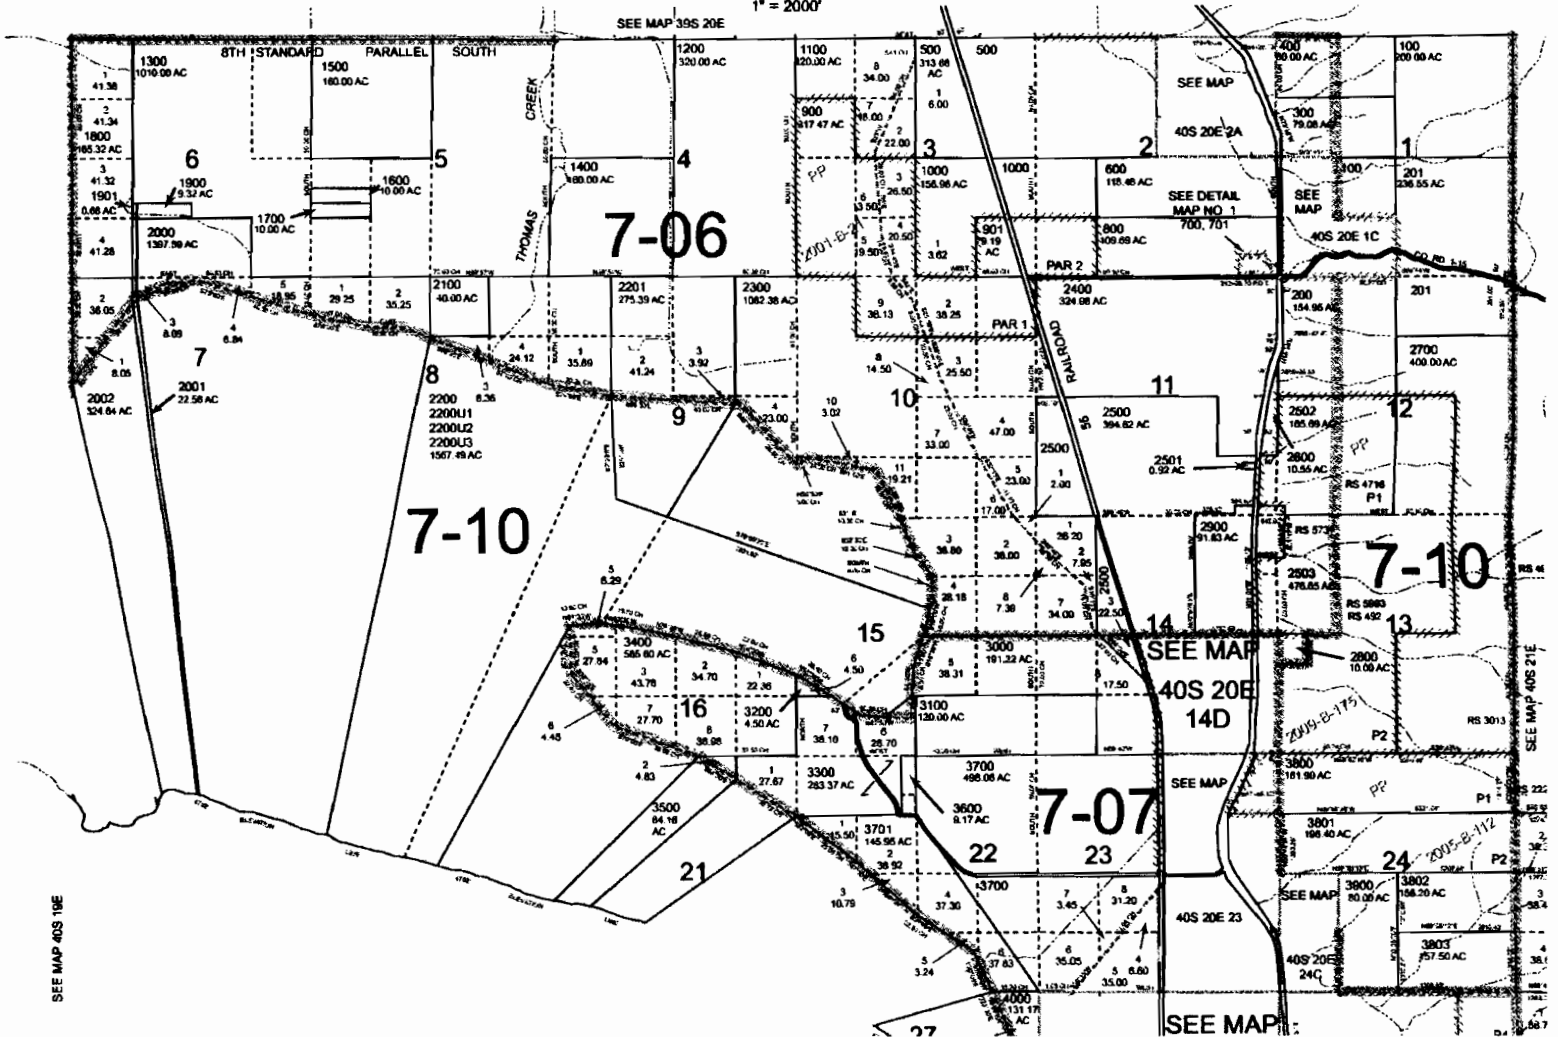

RECEIVED BY OWRD

JUL 23 2012

G-17572

SALEM, OR