


RECEIVED BY OWRD

JUL 23 2012

SALEM, OR

*YUKON POND*

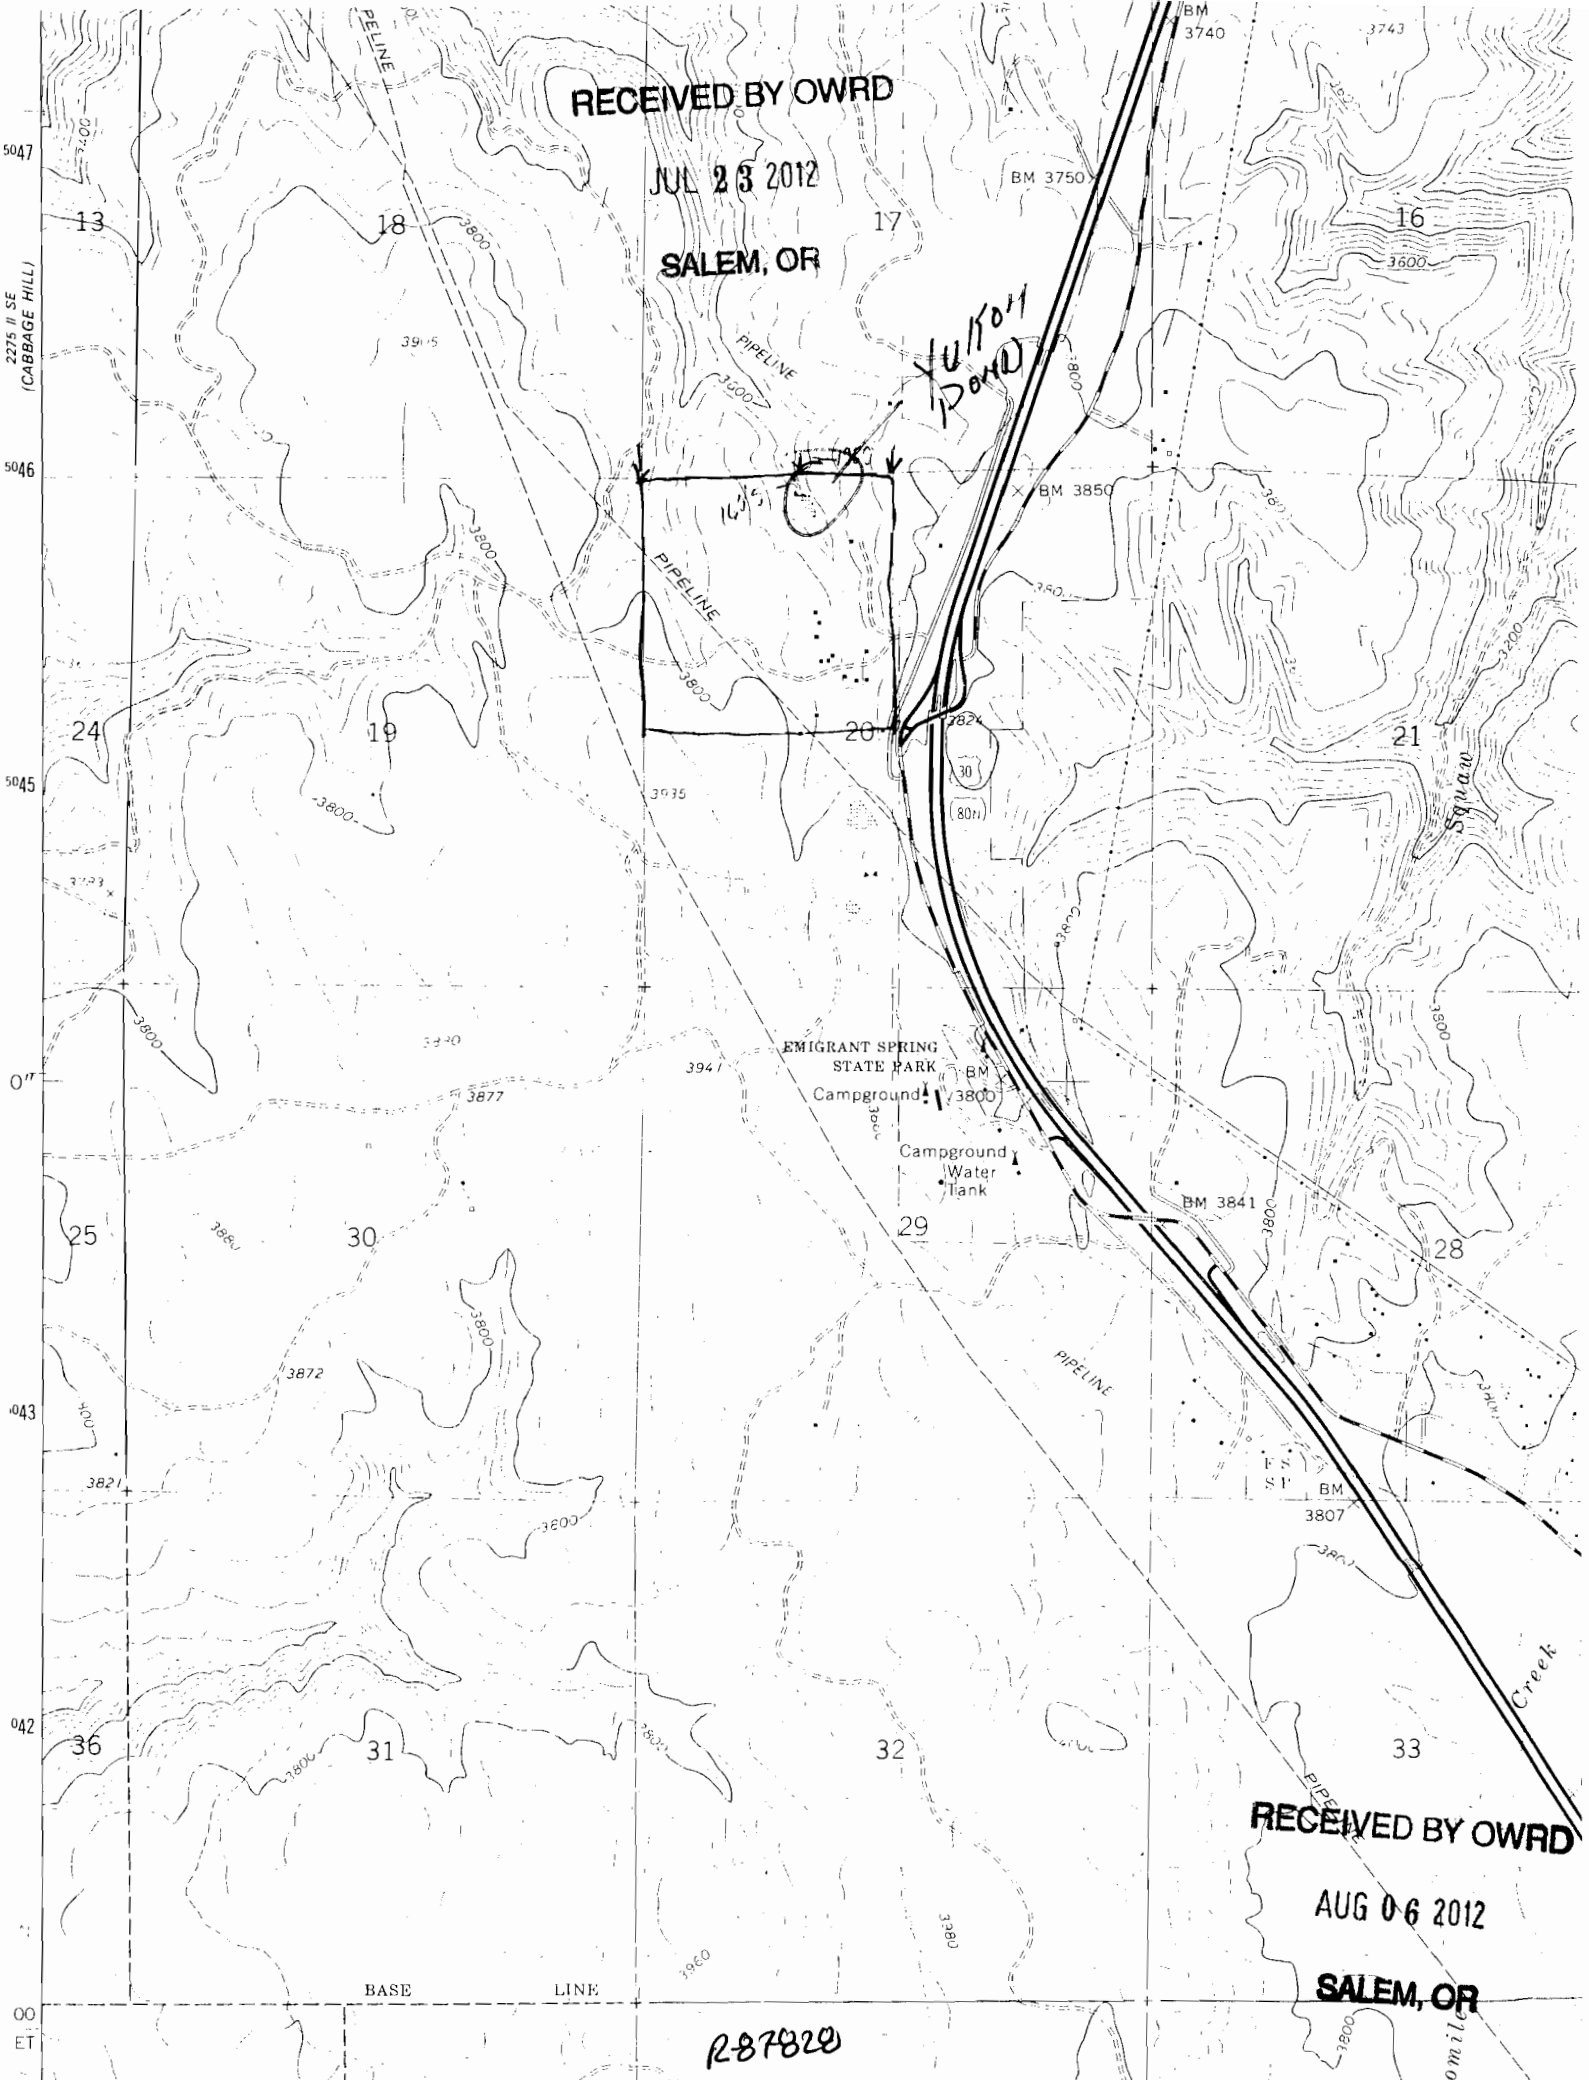

2275 II SE (CABBAGE HILL)

5047  
5046  
5045  
0''  
043  
042  
00  
ET

RECEIVED BY OWRD

AUG 06 2012

SALEM, OR

R-87829

omile

RECEIVED BY OWRD

JUL 23 2012

SALEM, OR

NW COR of NENW


T 1 N R 35 E

Section 20

SEE MAP 1N35

NENW

Dam location: 160' south and 1000' west from the N<sup>1</sup>/<sub>4</sub> corner of Section 20  
↑ N

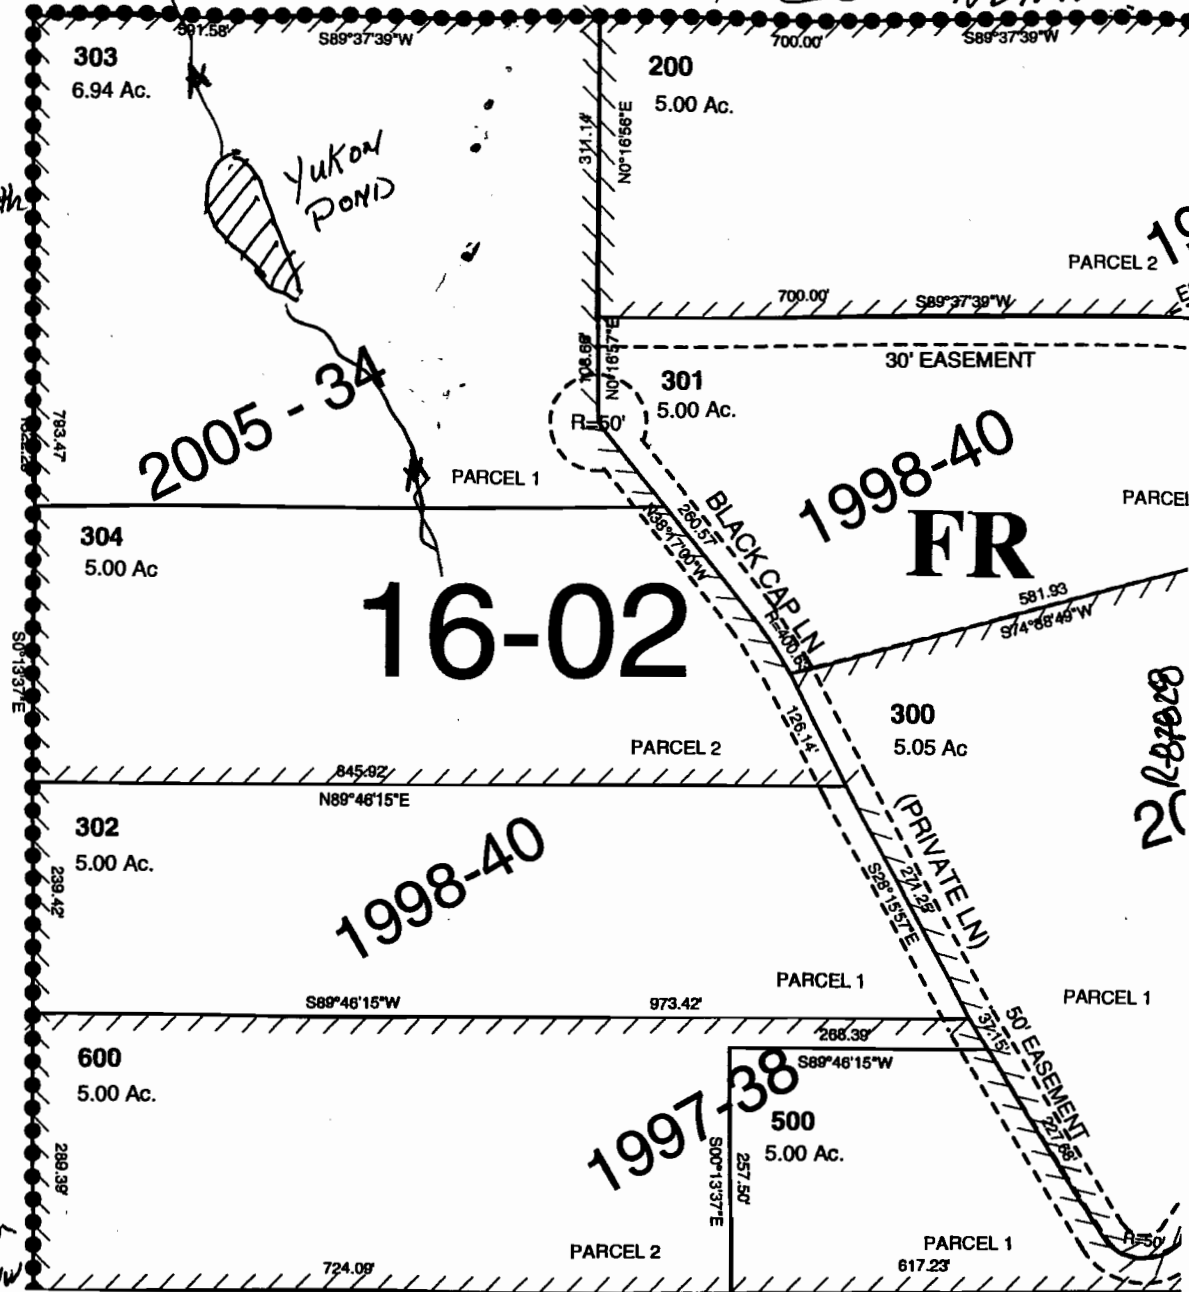

SEE MAP 1N35

1" = 200'

RECEIVED BY OWRD

AUG 04 2012

SALEM, OR

10

2005-34