


# Reservoir Location Map

## 35S-1W-07-SE-SE

### Taxlot 313

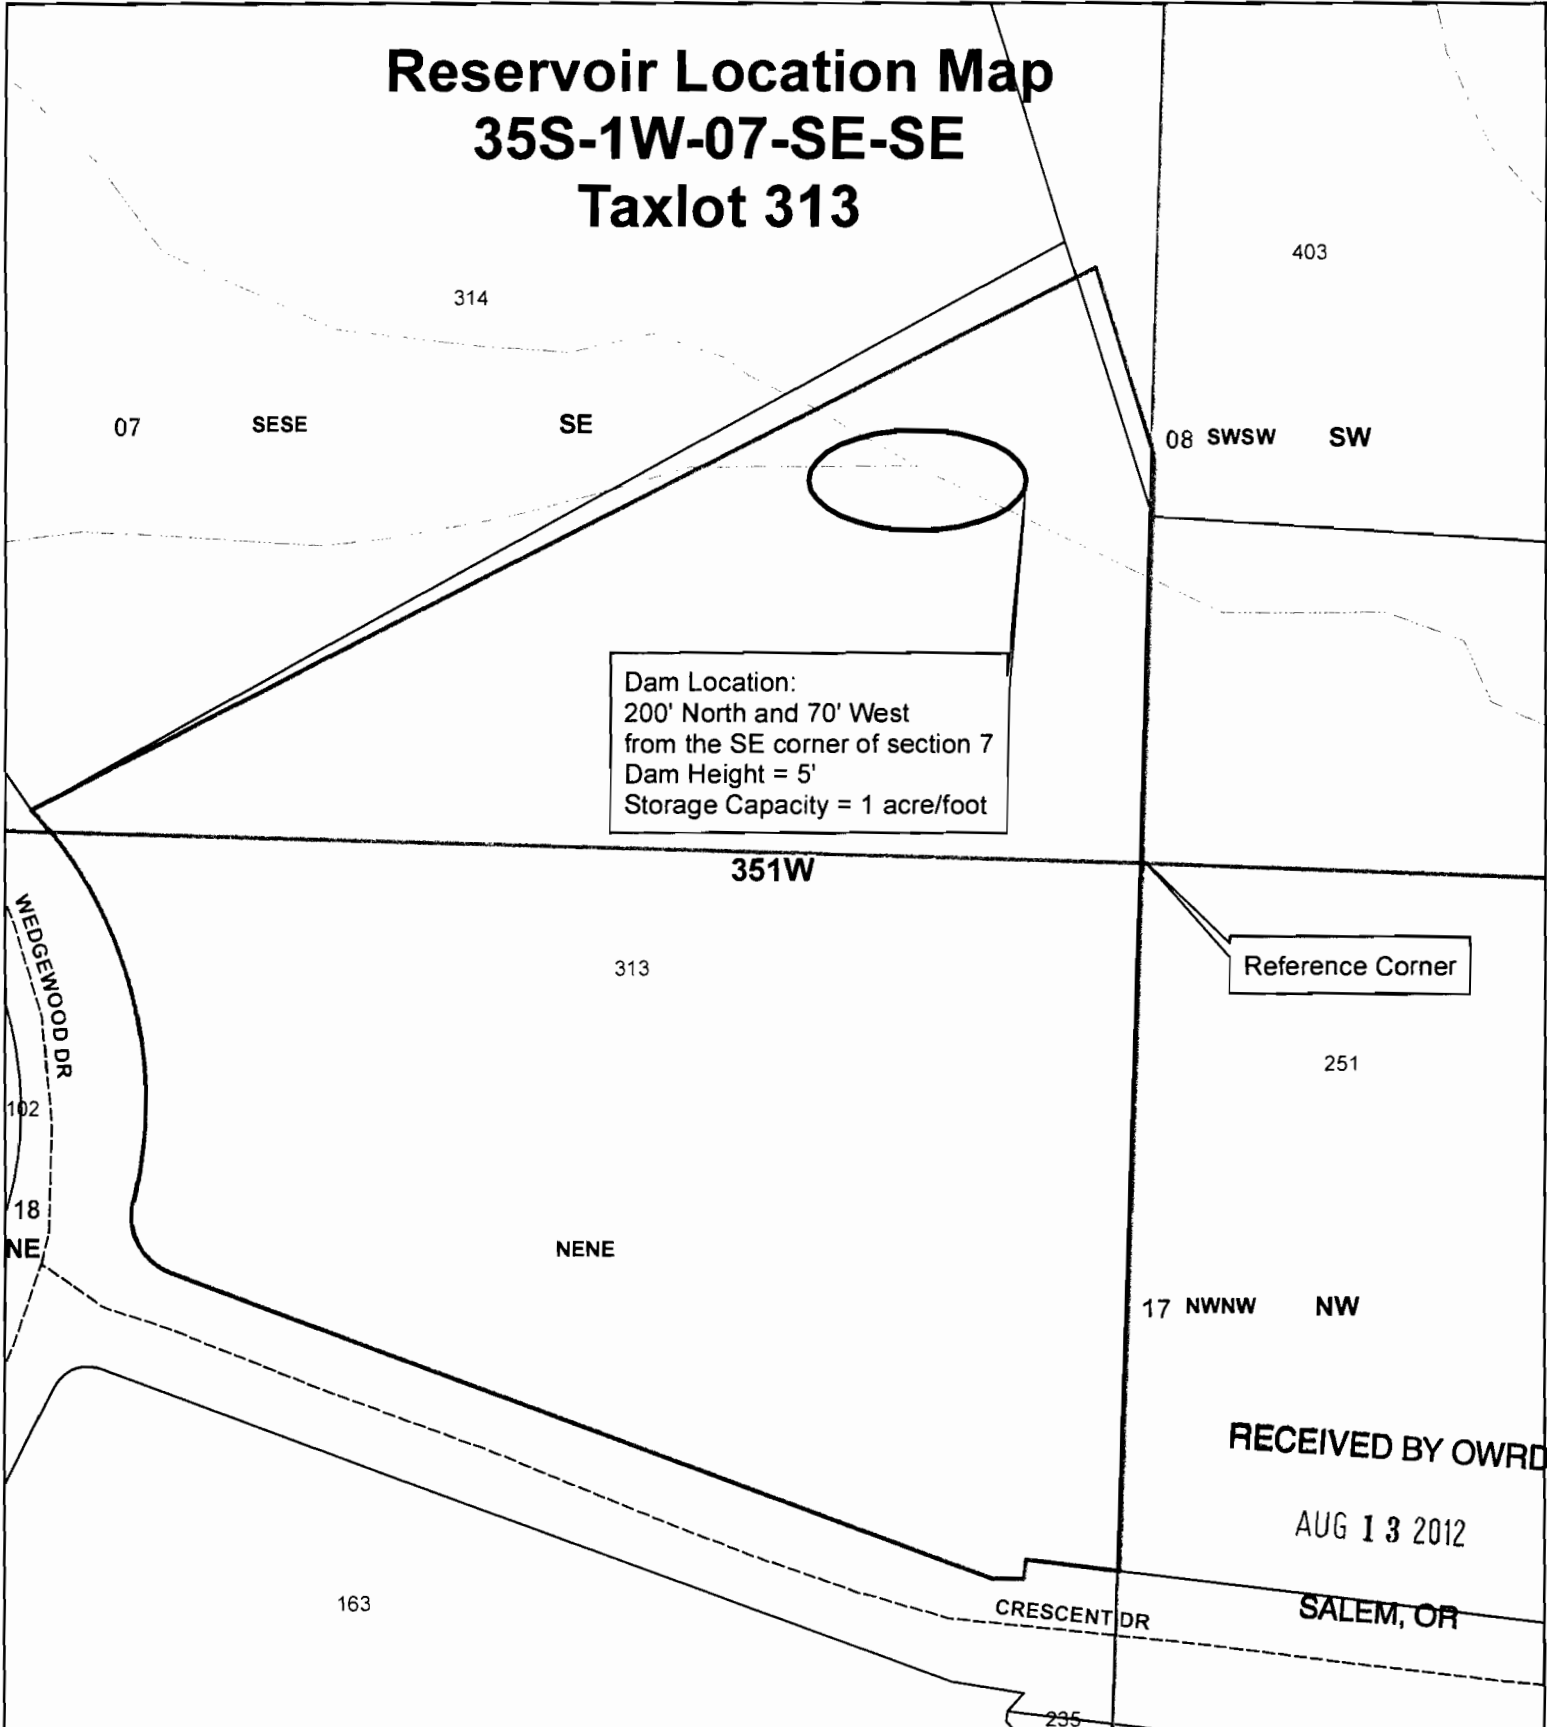

Dam Location:  
 200' North and 70' West  
 from the SE corner of section 7  
 Dam Height = 5'  
 Storage Capacity = 1 acre/foot

Reference Corner

**RECEIVED BY OWRD**


**AUG 13 2012**

**SALEM, OR**

**Legend**

- Reservoir
- Townships
- Sections
- Quarter Sections
- Quarter Quarter Sections
- Taxlots
- Intermittent Streams

1 inch = 100 feet

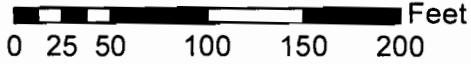

R-87810

**JACKSON COUNTY  
WATERMASTER**

This map is based on a digital database compiled by Jackson County from a variety of sources. Jackson County cannot accept responsibility for errors, omissions, or positional accuracy. There are no warranties, expressed or implied.