


T14S. R.39E. W.M.  
SCALE 1" = 1320'

Tax Lot No 3701

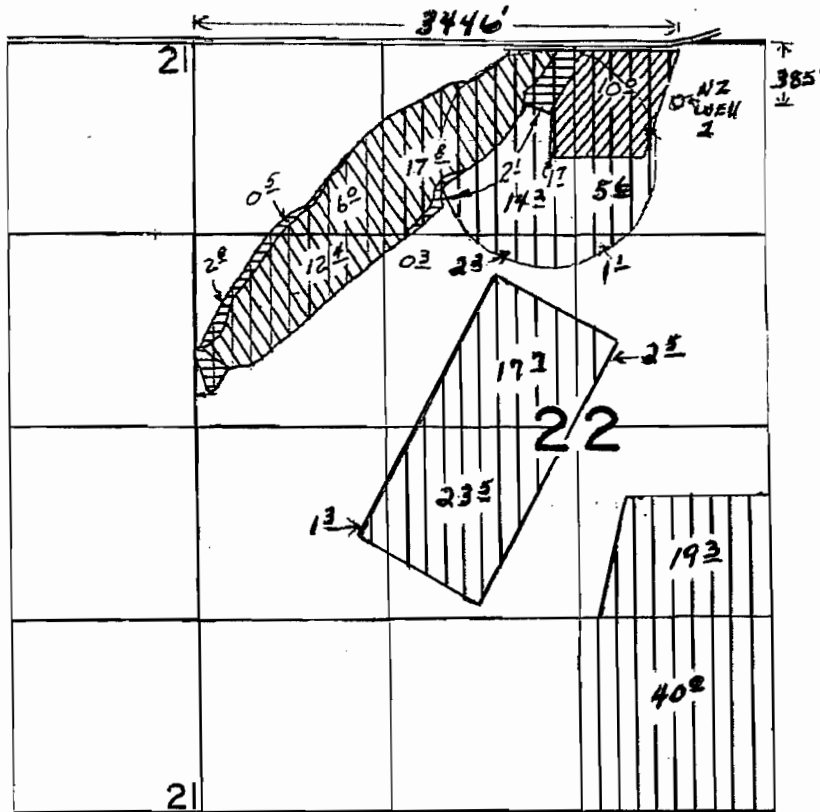

Proposed  
Primary

Primary for  
Certificate  
50392

Suppl.

Primary Cert  
55002

RECEIVED BY OWRD

AUG 27 2012

SALEM, OR


RECEIVED BY OWRD

AUG 15 2012

SALEM, OR

G-17577

# T. 14 S. R. 39 E. W. M.

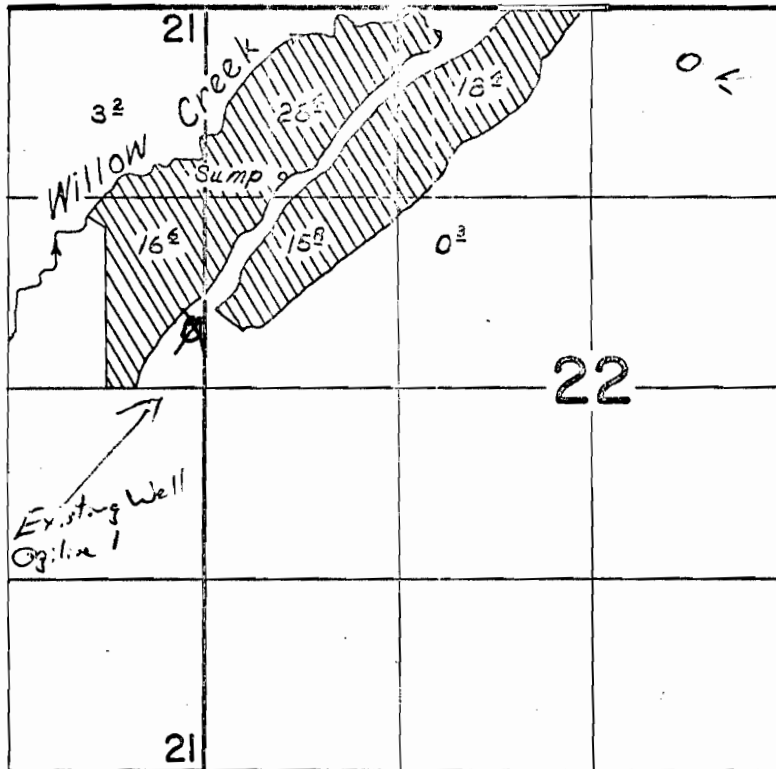

**FINAL PROOF SURVEY**  
UNDER

**RECEIVED BY OWRD**

AUG 27 2012

Application No. *G-1406* Permit No. *G-1281*  
IN NAME OF

**SALEM, OR**

**MARVIN E. & MARIE G. OGILVIE**

Surveyed *July 13 1962*, by *C. R. Baker*

*G-17577*