


Map of the Flume Creek Watershed

RECEIVED BY OWRD

AUG 24 2012

SALEM, OR

Edge of the Flume  
Watershed

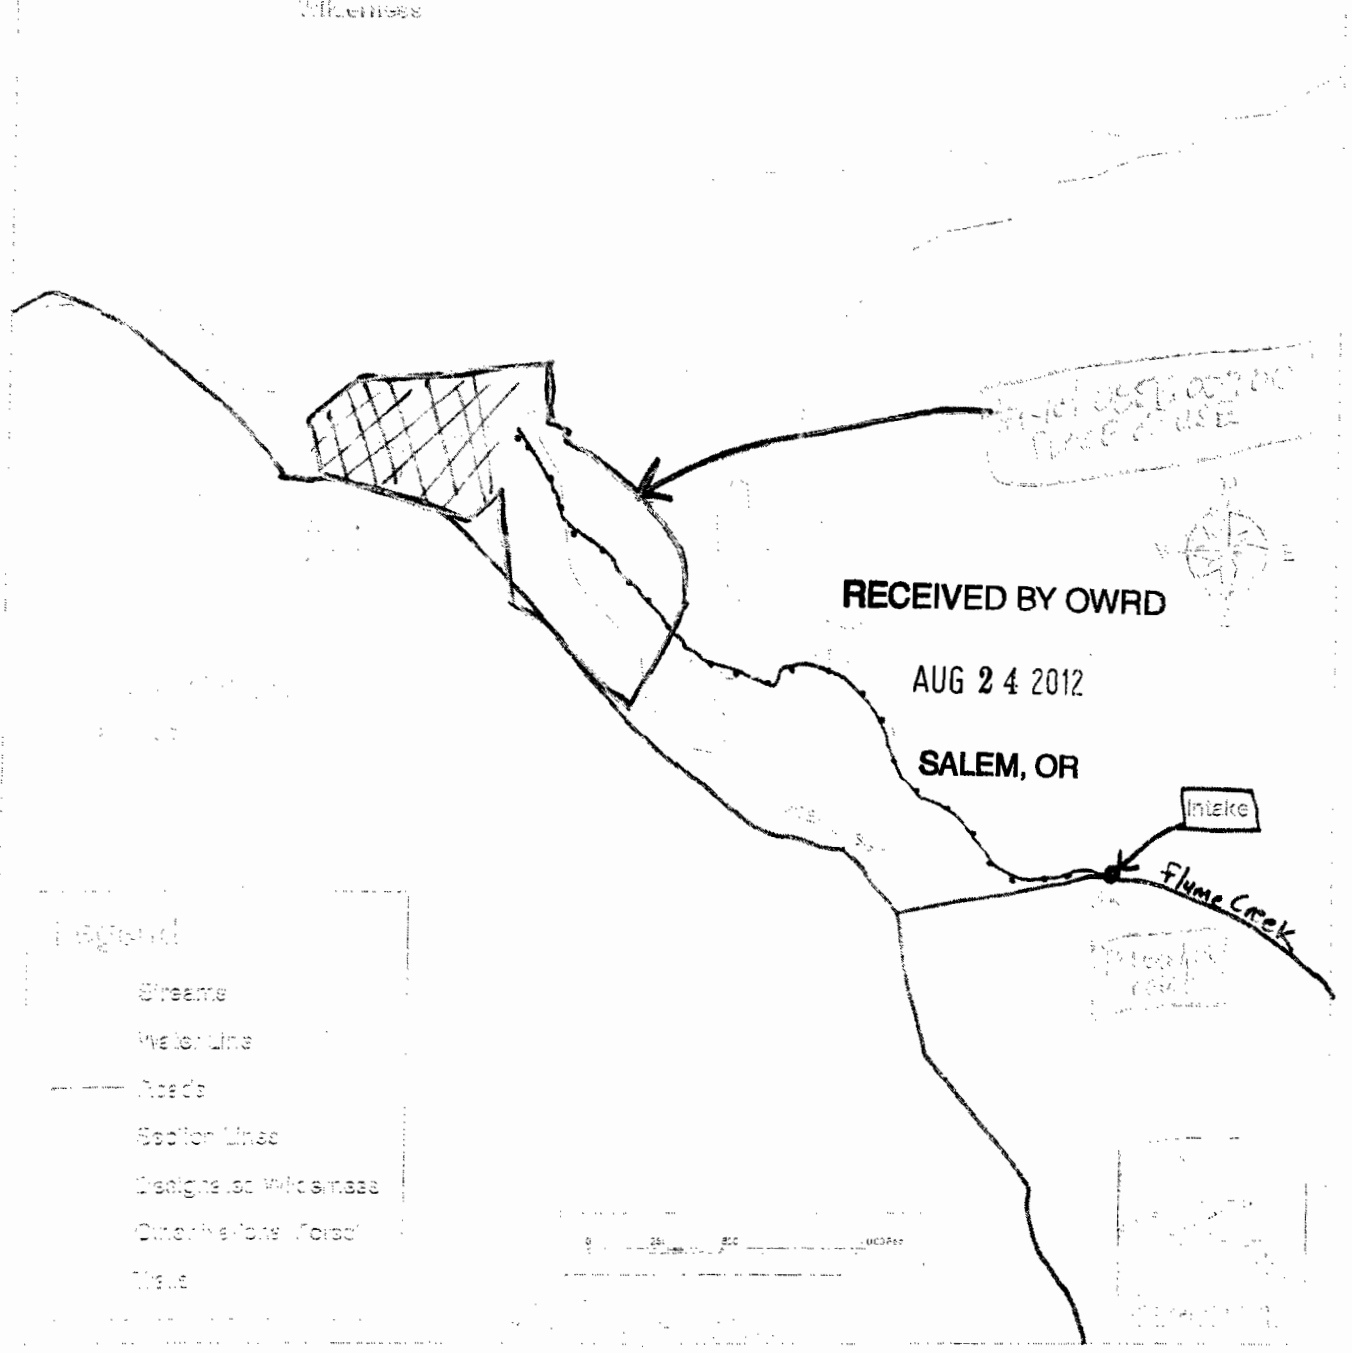


RECEIVED BY OWRD

AUG 24 2012

SALEM, OR

- Legend
- Streams
  - Water Line
  - Roads
  - Section Lines
  - Designated Wilderness
  - Other Watershed Forest
  - Title

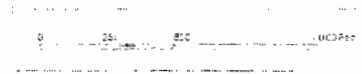


~~S-87085~~ P-87033

OF

T8S R5E WM, MARION COUNTY

P.O.D. LOCATED from SE  
CORNER SECT. 28  
730 ft SOUTH  
1250 ft WEST  
S29 49W / 80.46 CH

129

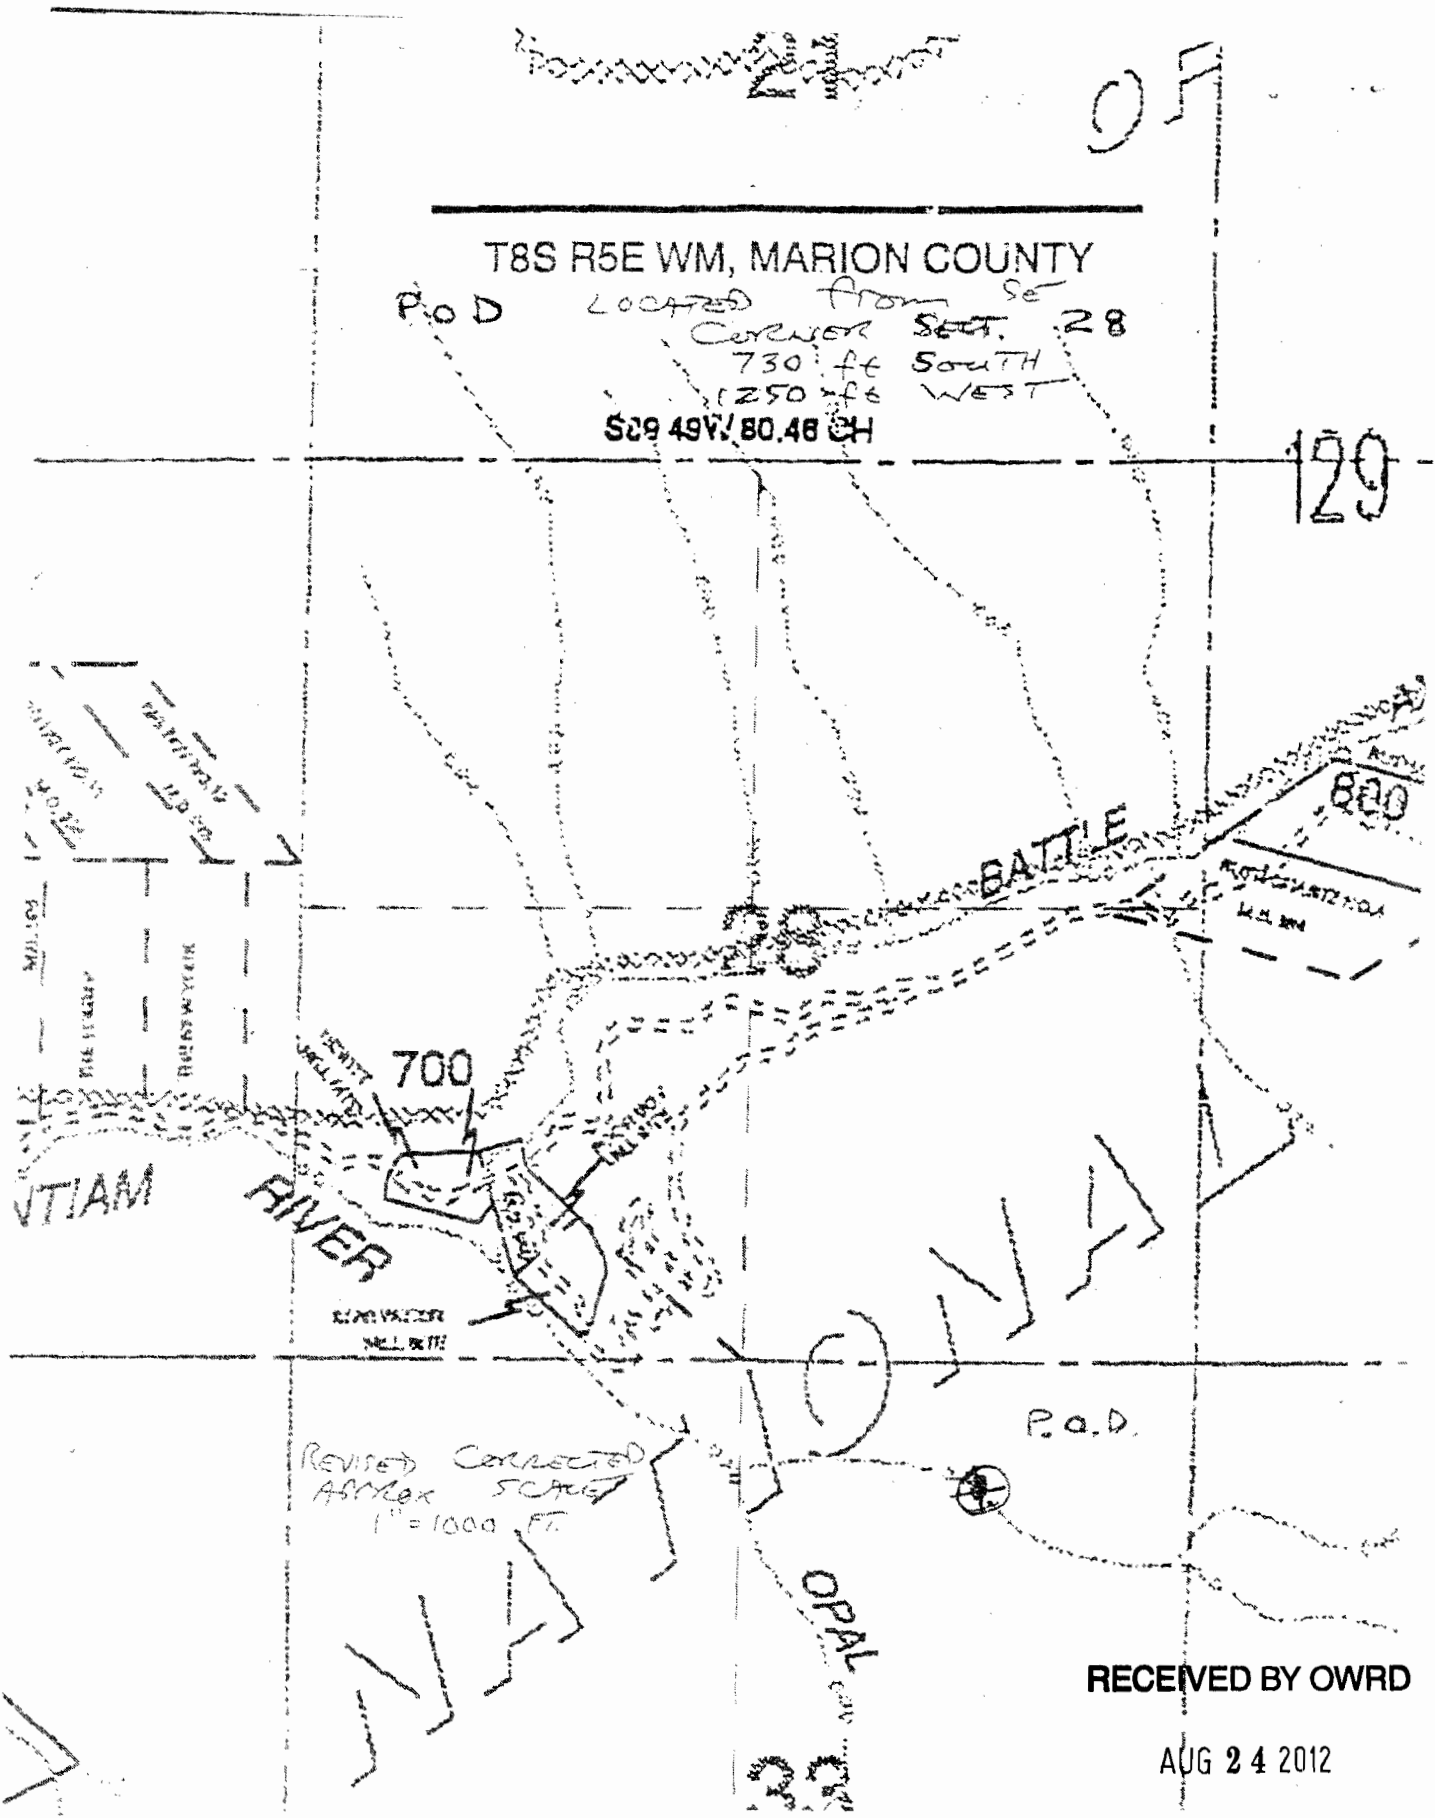

BATTLE

800

700

VTIAM RIVER

REVISED CORRECTED  
ASMEK SCHEM  
1" = 1000 FT.

P.O.D.

OPAL

RECEIVED BY OWRD

AUG 24 2012

SALEM, OR

~~S-87883~~  
S-87833