


PERMIT AMENDMENT MAP

FOR GROUND WATER PERMIT APPLICATIONS G-17107 & G-17365 ANDY ROOT

TOWNSHIP 22 SOUTH, RANGE 33 EAST, SECTION 30, W.M.
TAX LOTS: 303 & 1800

SCALE: 4 INCHES = 1 MILE

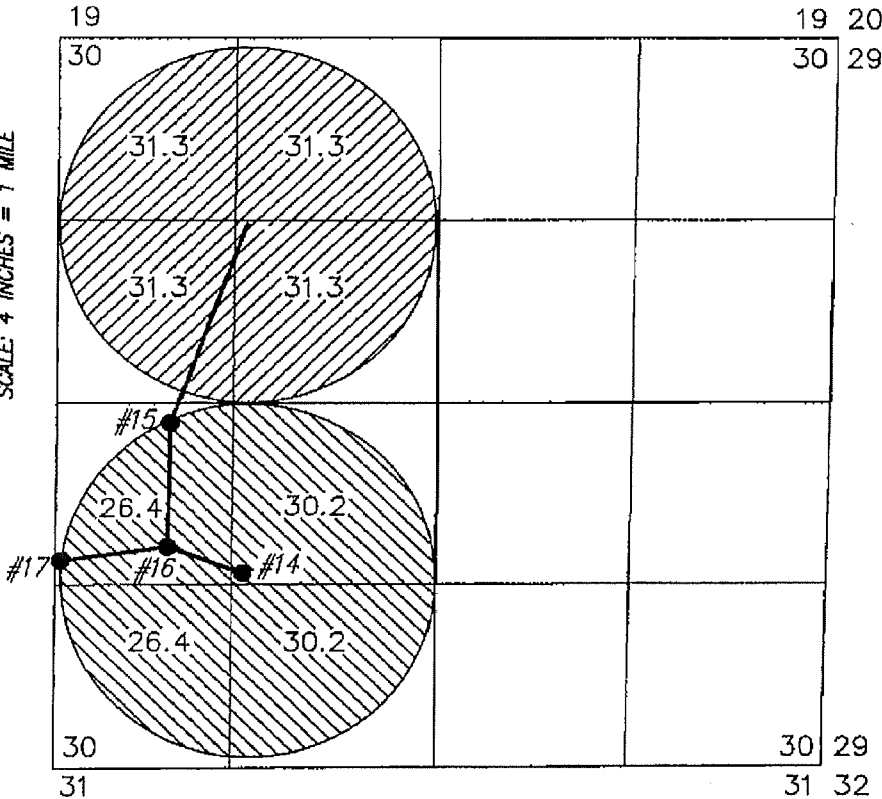


- **WELL 14 (HARN 51475)**
EXISTING WELL IN THE NE 1/4 OF THE SW 1/4 OF SECTION 30 LOCATED 1254 FEET NORTH AND 1240 FEET EAST FROM THE SW CORNER OF SECTION 30, TOWNSHIP 22 SOUTH, RANGE 33 EAST, W.M., HARNEY COUNTY, OREGON
- **WELL 15 (HARN 51275)**
EXISTING WELL IN THE NW 1/4 OF THE SW 1/4 OF SECTION 30 LOCATED 2508 FEET NORTH AND 780 FEET EAST FROM THE SW CORNER OF SECTION 30, TOWNSHIP 22 SOUTH, RANGE 33 EAST, W.M., HARNEY COUNTY, OREGON
- **WELL 16 (HARN 51823)**
NEW WELL IN THE NW 1/4 OF THE SW 1/4 OF SECTION 30 LOCATED 1610 FEET NORTH AND 780 FEET EAST FROM THE SW CORNER OF SECTION 30, TOWNSHIP 22 SOUTH, RANGE 33 EAST, W.M., HARNEY COUNTY, OREGON
- **WELL 17 (HARN 206)**
PROPOSED WELL IN THE NW 1/4 OF THE SW 1/4 OF SECTION 30 LOCATED 1500 FEET NORTH AND 50 FEET EAST FROM THE SW CORNER OF SECTION 30, TOWNSHIP 22 SOUTH, RANGE 33 EAST, W.M., HARNEY COUNTY, OREGON

- 113.2 ACRES PRIMARY IRRIGATION TO REMAIN FROM APP. G-17365, AS SHOWN
- 125.2 ACRES PRIMARY IRRIGATION TO REMAIN FROM APP. G-17107, AS SHOWN

RECEIVED

SEP 11 2012

WATER RESOURCES DEPT
SALEM, OREGON

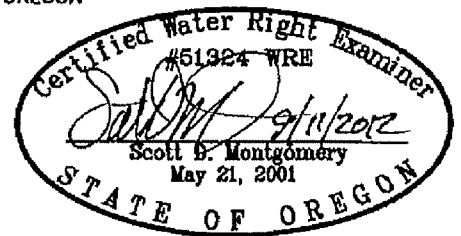

RENEWAL DATE: 12/31/2012

THIS MAP IS FOR THE PURPOSE OF DESIGNING AN IRRIGATION SYSTEM PLAN AND HAS NO INTENT TO PROVIDE LEGAL DIMENSIONS OR THE LOCATION OF PROPERTY LINES

PREPARED FOR:

ANDY ROOT
524 HWY 20 N
HINES, OR 97738

PREPARED BY:



ALL POINTS ENGINEERING AND SURVEYING, INC.
P.O. BOX 767 (CRR) TERREBONNE, OR 97760
(541) 548-5833 www.APEandS.com

Kerry Kavanagh

From: Scott <scott@apeands.com>
Sent: Tuesday, September 11, 2012 6:52 PM
To: 'Kerry Kavanagh'
Subject: Permit App G-17365
Attachments: PermitAmendmentMapCowCreek.pdf

Hi Kerry,

The map should have listed Well 14 in the NE of the SW of Section 30. The assessor's map lists the distance from the SW corner of the section to the W 1/16 corner as 1307.2 feet. I've attached a revised map correcting the called out 1/16 corner of the section where the well is supposed to be.

Thanks,

*Scott Montgomery, Owner/Principal
All Points Engineering and Surveying, Inc.
(541) 548-5833*

RECEIVED

SEP 11 2012

WATER RESOURCES DEPT
SALEM, OREGON