


T. 30S. R. 10&11 E. W. M.

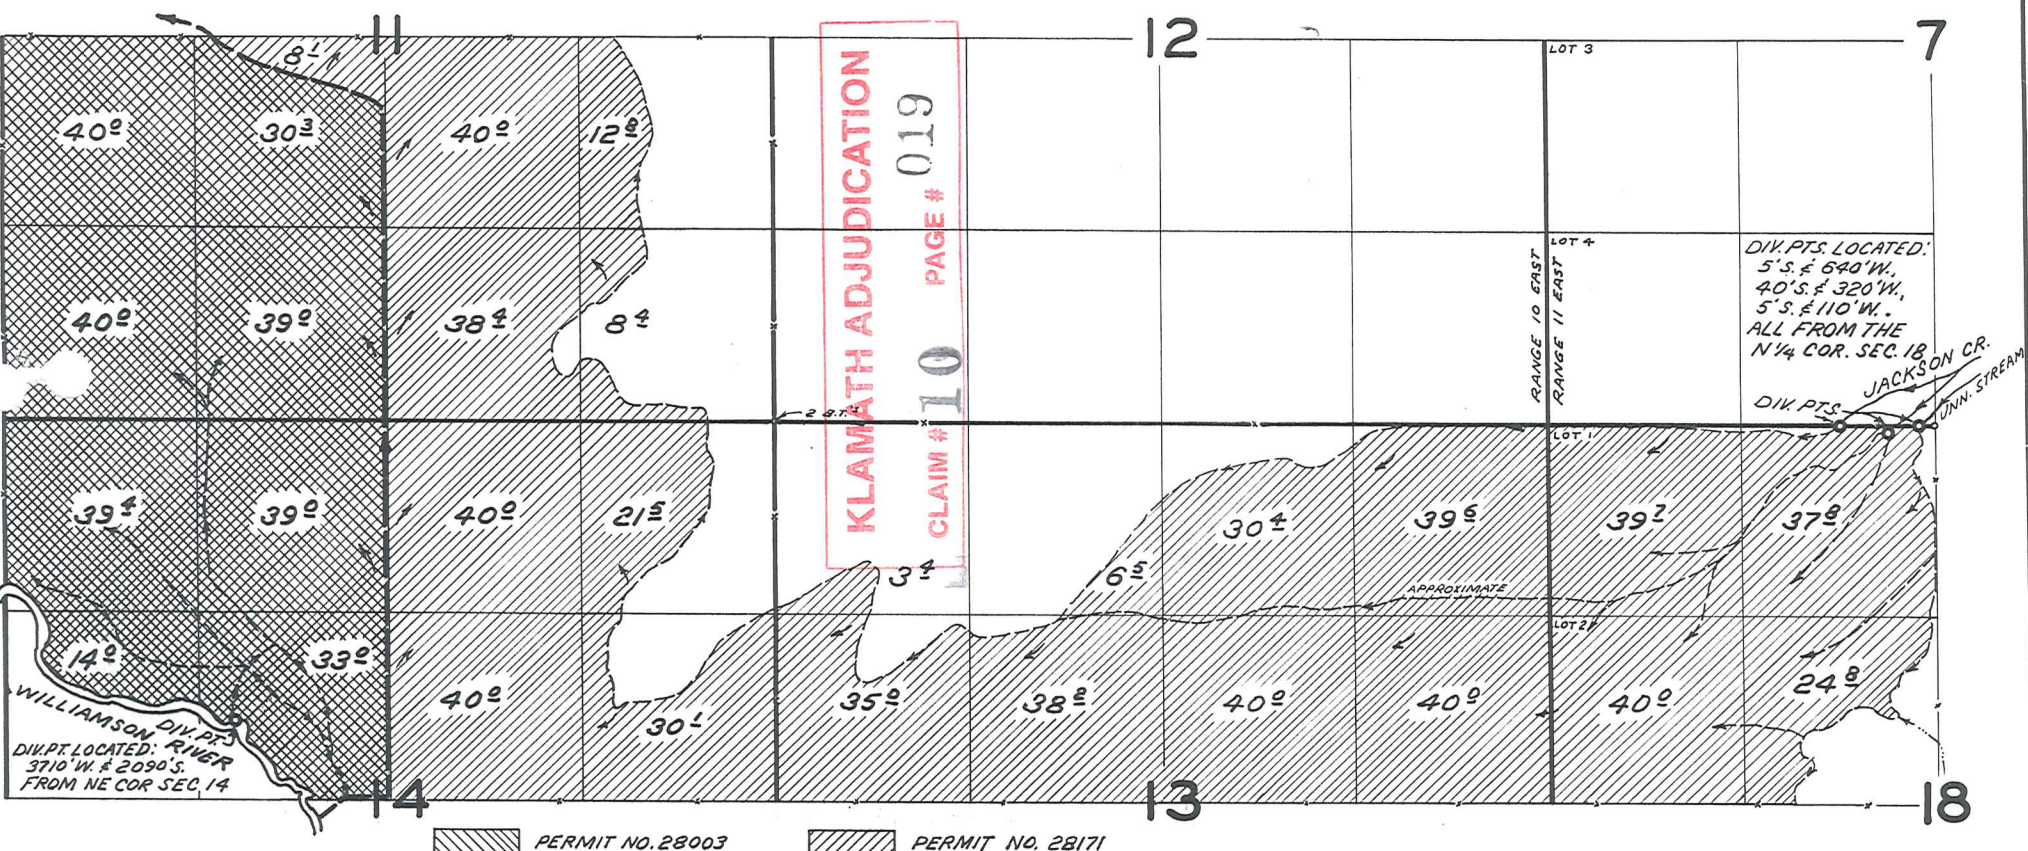

# FINAL PROOF SURVEY UNDER

APPLICATION NO. 37574, PERMIT NO. 28171  
37587 28003

IN NAME OF

*ESTATE OF MRS. ANNIE FRANCIS*

SURVEYED JUN. 25, 1967, BY V. GARNER

*EXCEPTED AS DRAWN  
Kenneth I. Huffard*

RECEIVED

OCT 06 1998

WATER RESOURCES DEPT.  
SALEM, OREGON