


KLAMATH ADJUDICATION
CLAIM # 9 PAGE # 025

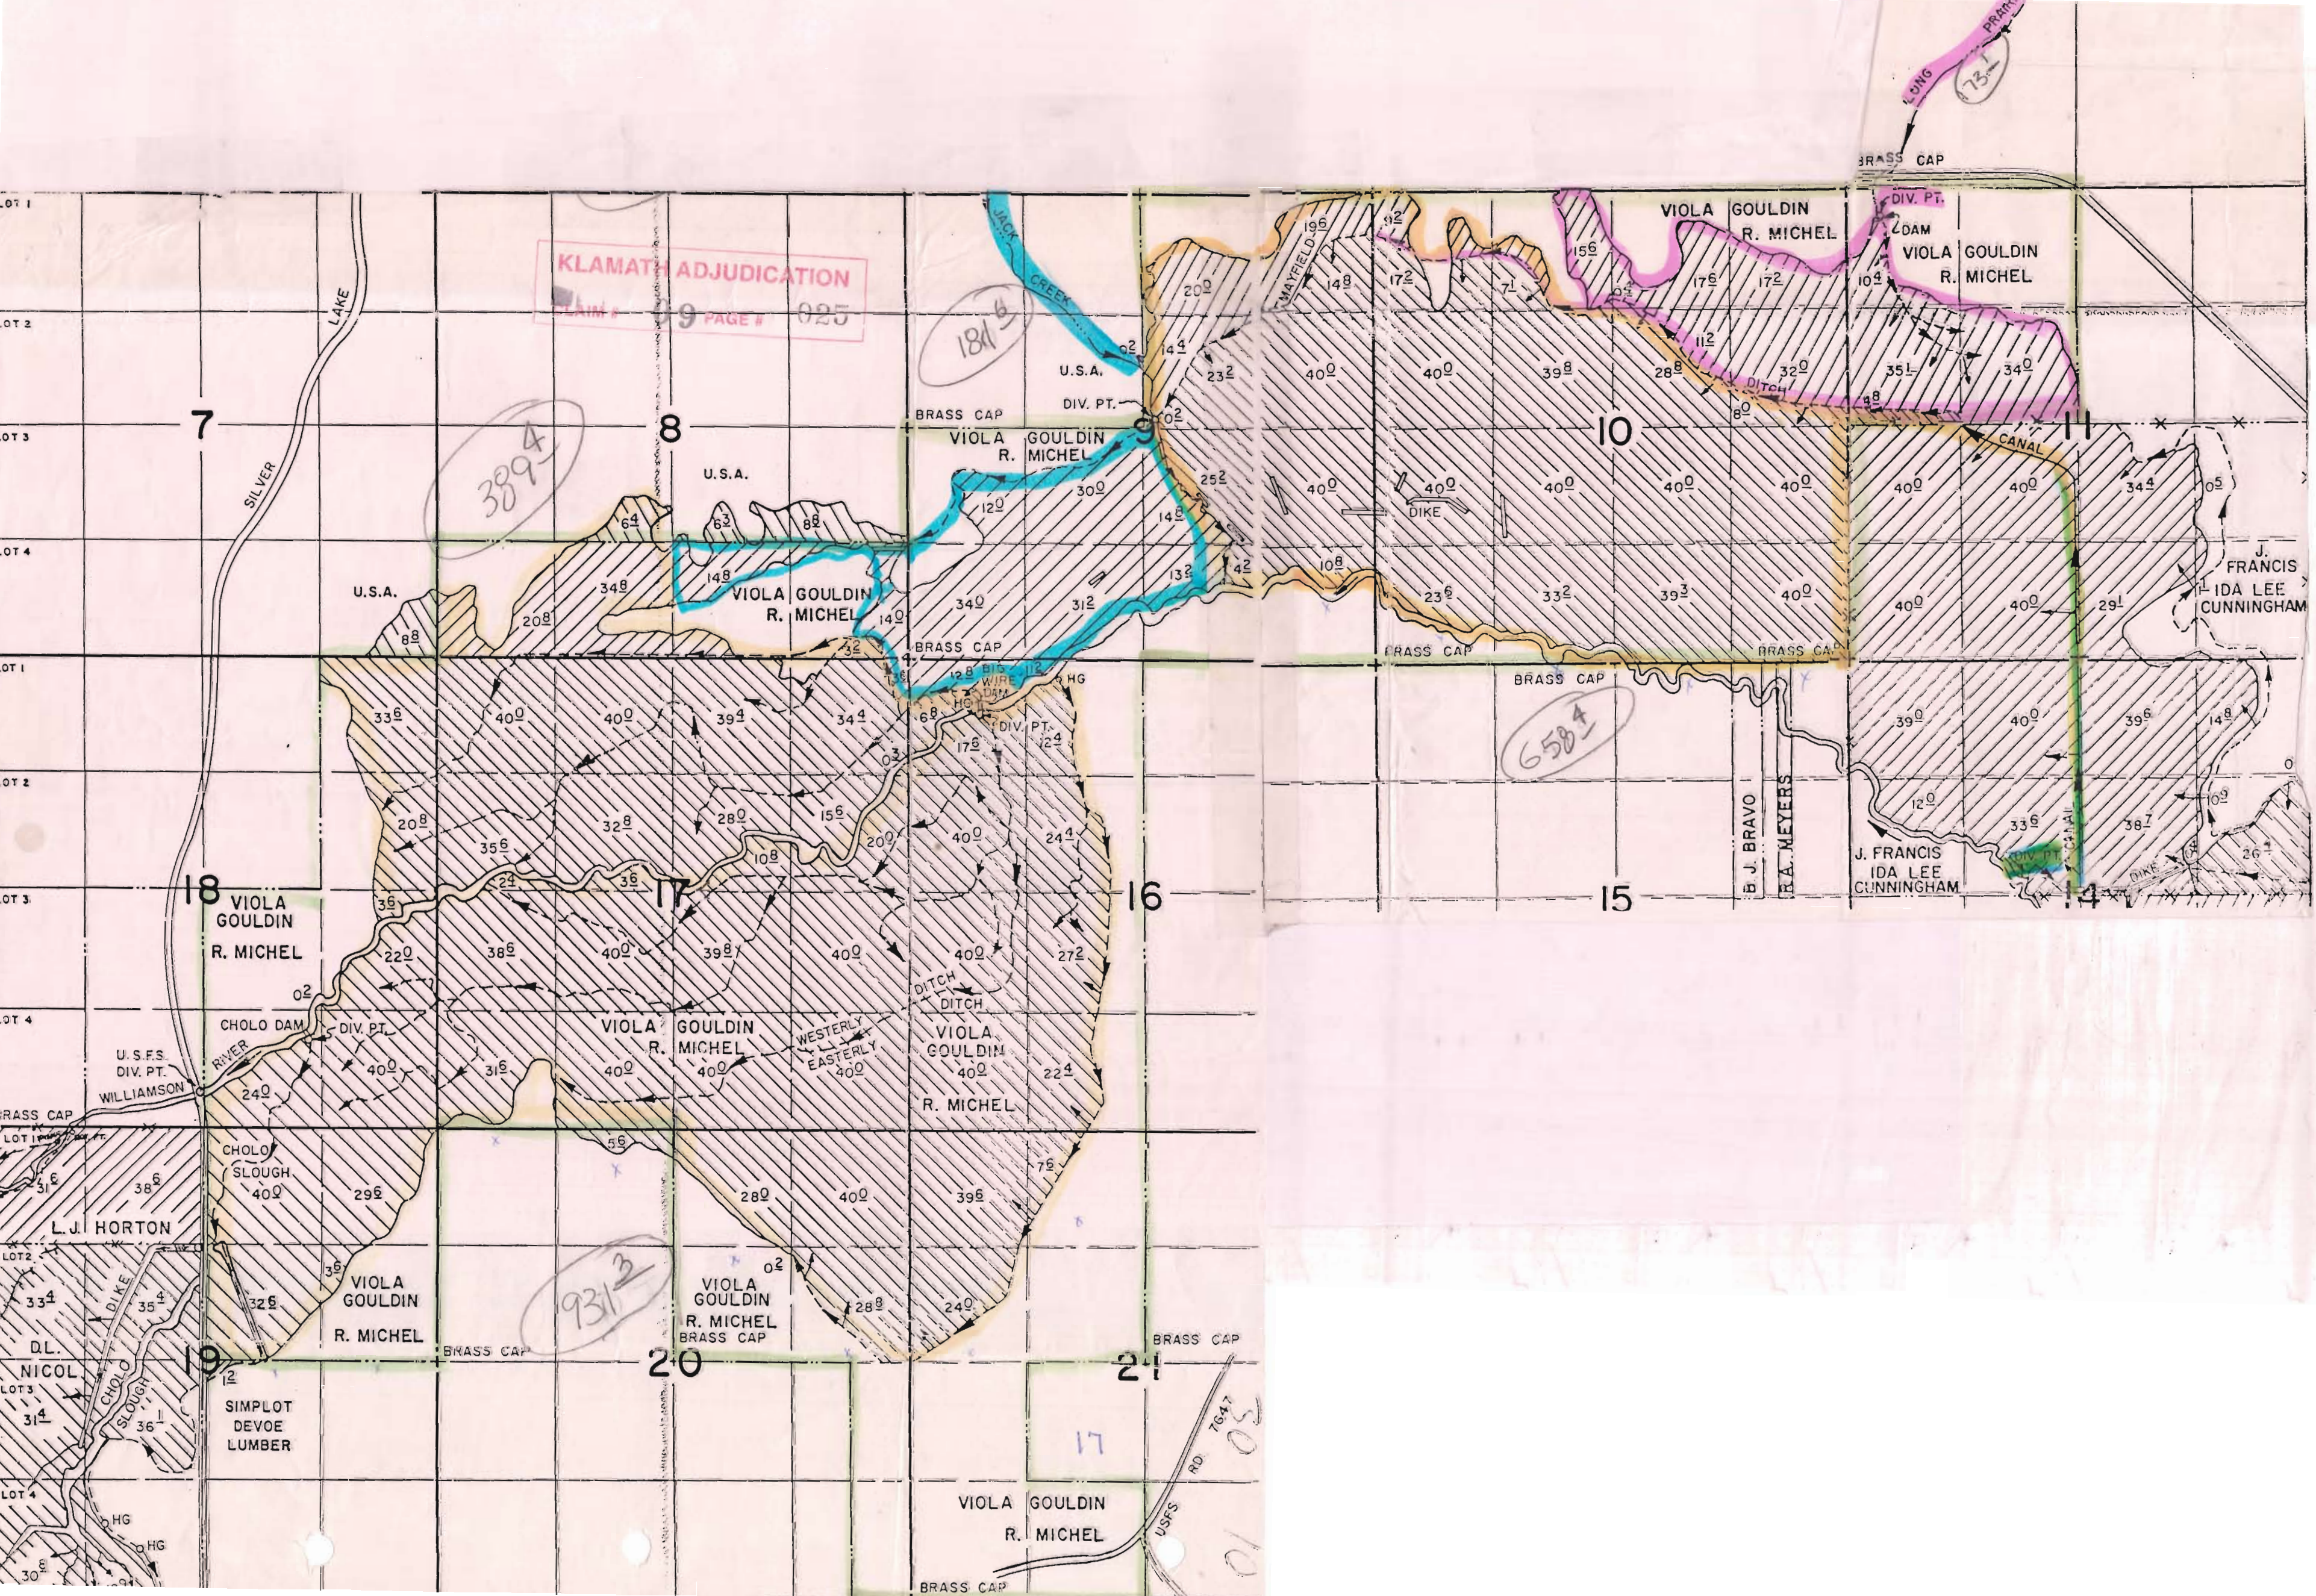

3894

1816

6584

9313

RD 7647
USFS
10/02