


26669
29023

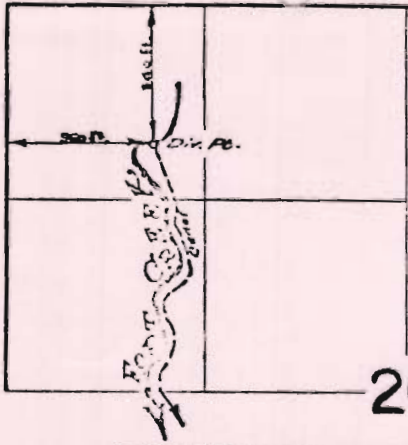


T.33 & 34 S. R. 7 1/2 E. W.M.

RECEIVED

JUN 28 1991

WATER RESOURCES DEPT.
SALEM, OREGON

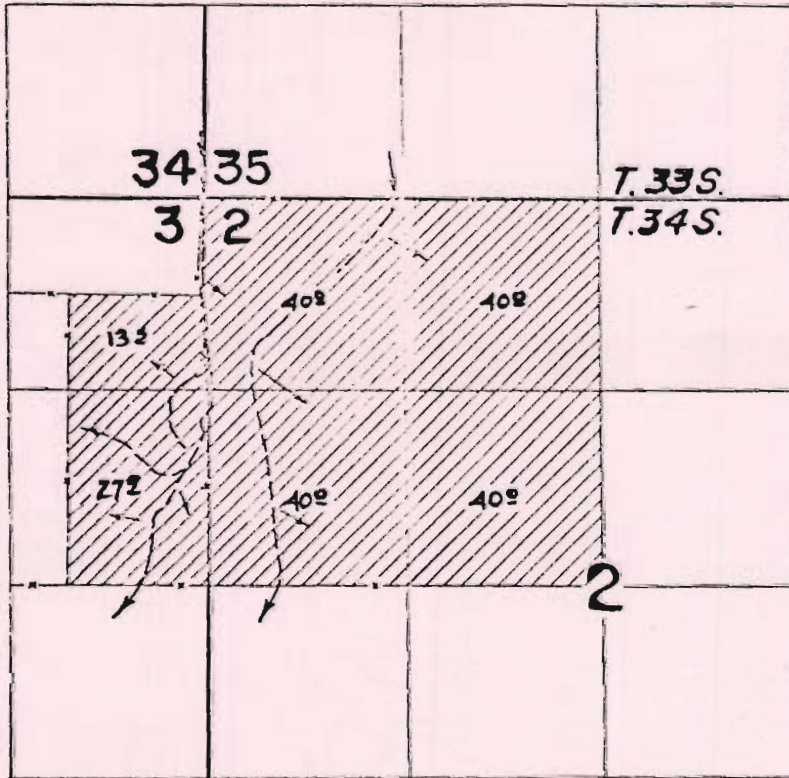


KLAMATH ADJUDICATION
 CLAIM # **62** PAGE # **08**

FINAL PROOF SURVEY
UNDER

Application No. 33730 Permit No. 26669
 IN NAME OF

LLOYD G. & DOROTHY M. NICHOLSON

Surveyed August 19 1964. by *L. Johnson*