



MAP TO ACCOMPANY STATEMENT AND PROOF OF CLAIM TO USE OF WATER OF THE KLAMATH RIVER AND ITS TRIBUTARIES

SITUATED IN THE SE1/4 SECTION 28, THE W1/2 NE1/4 SECTION 33, AND
THE W1/2 NW1/4 SECTION 34, T35S, R12EWM, KLAMATH COUNTY, OREGON

JUNE 1991 - REVISED JUNE 2005

MAP PREPARED FOR -- RUSSELL & EDITH WALSH
CLAIM # 103

MAP PREPARED FROM MAPS OF APPLICATION #57268 - PERMIT #43105 AND
APPLICATION #61097 - PERMIT #45475, 1985 WAC AERIAL PHOTO AND FIELD
INSPECTION.

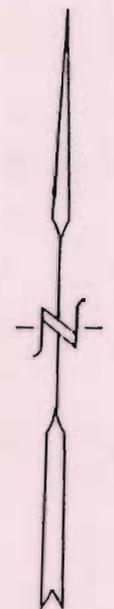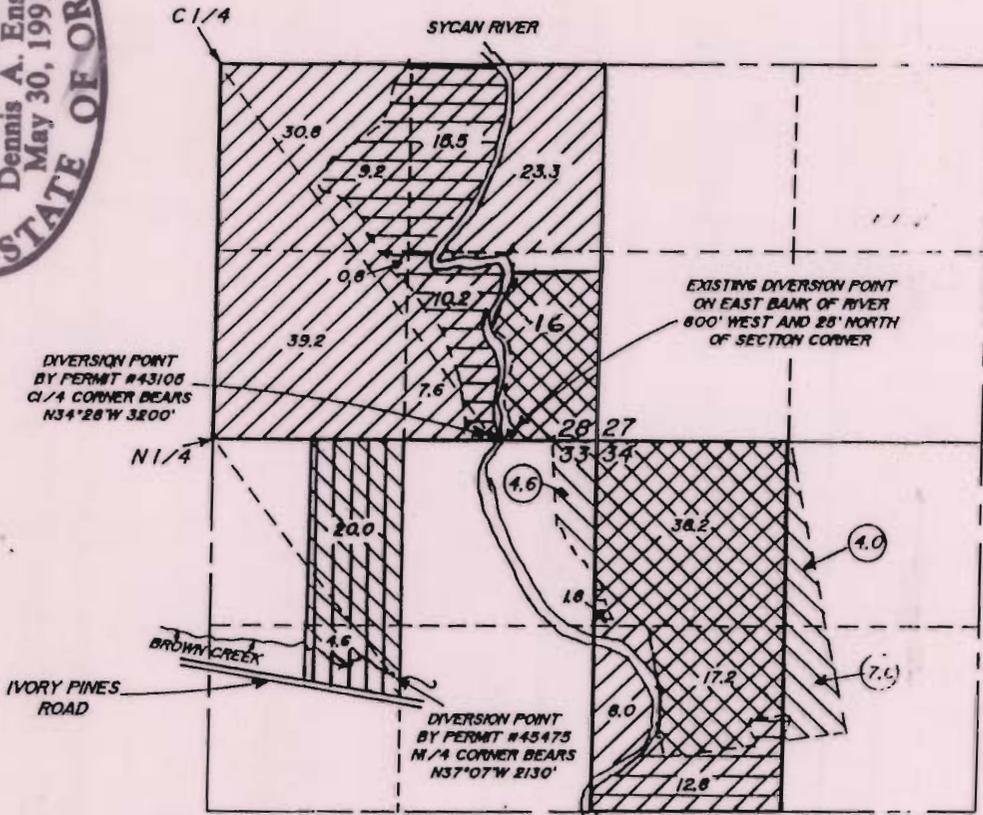

SCALE
1" = 1320'

- REVISED TO SHOW 71.4 AC OF 1864 WALTON RIGHT
- AREA COVERED BY APPLICATION #61097 - PERMIT #45475
- AREA COVERED BY APPLICATION #57268 - PERMIT #43105
- AREA BEING IRRIGATED WITH WHEEL LINE SPRINKLERS
- AREA IN GRASS OWNER CLAIMS TO HAVE BEEN IRRIGATED WITH BIG GUN SPRINKLER & HAND MOVE LINES

NOTE SEE ATTACHED AERIAL PHOTO FOR AREA UNDER GOVERNMENT CRP PROGRAM

(XX) AREA ADDED 7/11/91



RECEIVED

JUL 21 2005

WATER RESOURCES DEPT
SALEM, OREGON

TRU-LINE SURVEYING
2333 SUMMERS LANE
KLAMATH FALLS, OR. 97603

THE PURPOSE OF THIS MAP IS TO IDENTIFY THE LOCATION OF THE WATER RIGHT. IT IS NOT INTENDED TO PROVIDE INFORMATION RELATIVE TO THE LOCATION OF PROPERTY OWNERSHIP BOUNDARY LINES.