


T.35S.R.12-13E.W.M.

Sycam R. below Sycam marsh

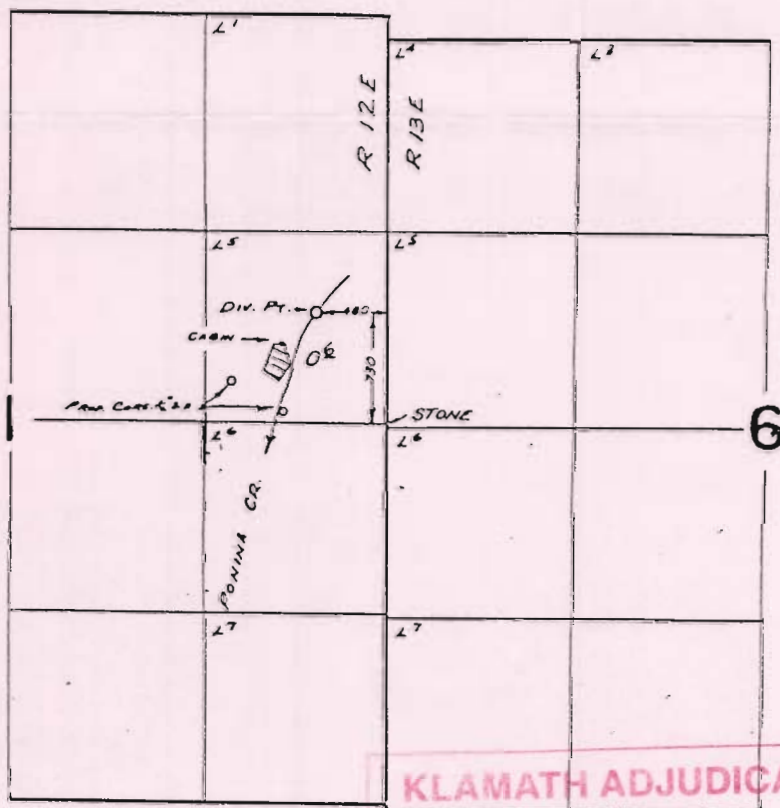

KLAMATH ADJUDICATION

CLAIM 104 PAGE 00014

FINAL PROOF SURVEY UNDER

Application No. 41727..... Permit No. 31279.....
 IN NAME OF

A. C. YADEN

Surveyed MAY 14 1970, by R. MUCKEN