


28441
14

T.35S.R.13E.W.M.

RECEIVED

MAY 1 2 1998

WATER RESOURCES DEPT.
SALEM, OREGON

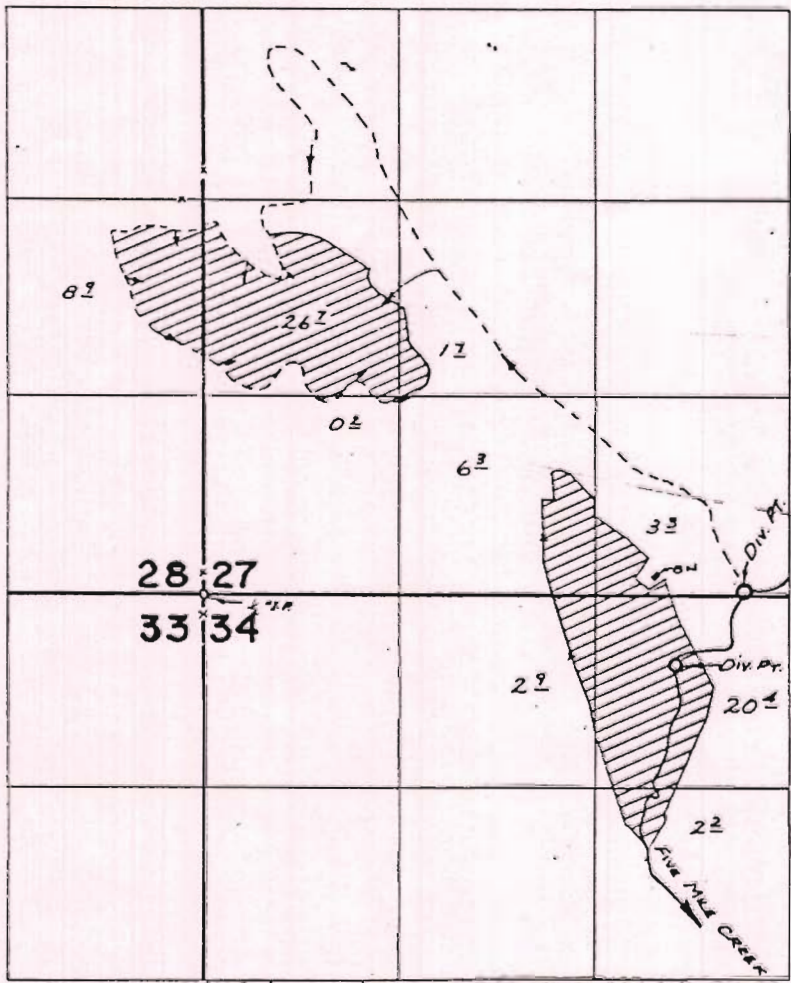

11. sh. Sprague R. & Meade

KLAMATH ADJUDICATION
CLAIM # 105 PAGE 00014

FINAL PROOF SURVEY
UNDER

Application No. 38151..... Permit No. 28441.....
IN NAME OF
PERCY & MARCELLA H. MURRAY &
WILLIAM V. & DORIS MEADE.....

Surveyed MAY 21, 1970., by R. MUCKEN.....