

ADDED TO FILE

BY

DWIGHT FRENCH


4-18-91

KLAMATH ADJUDICATION
CLAIM # **141** PAGE # **016**

RECEIVED

JUN - 2 1998

WATER RESOURCES DEPT.
SALEM, OREGON

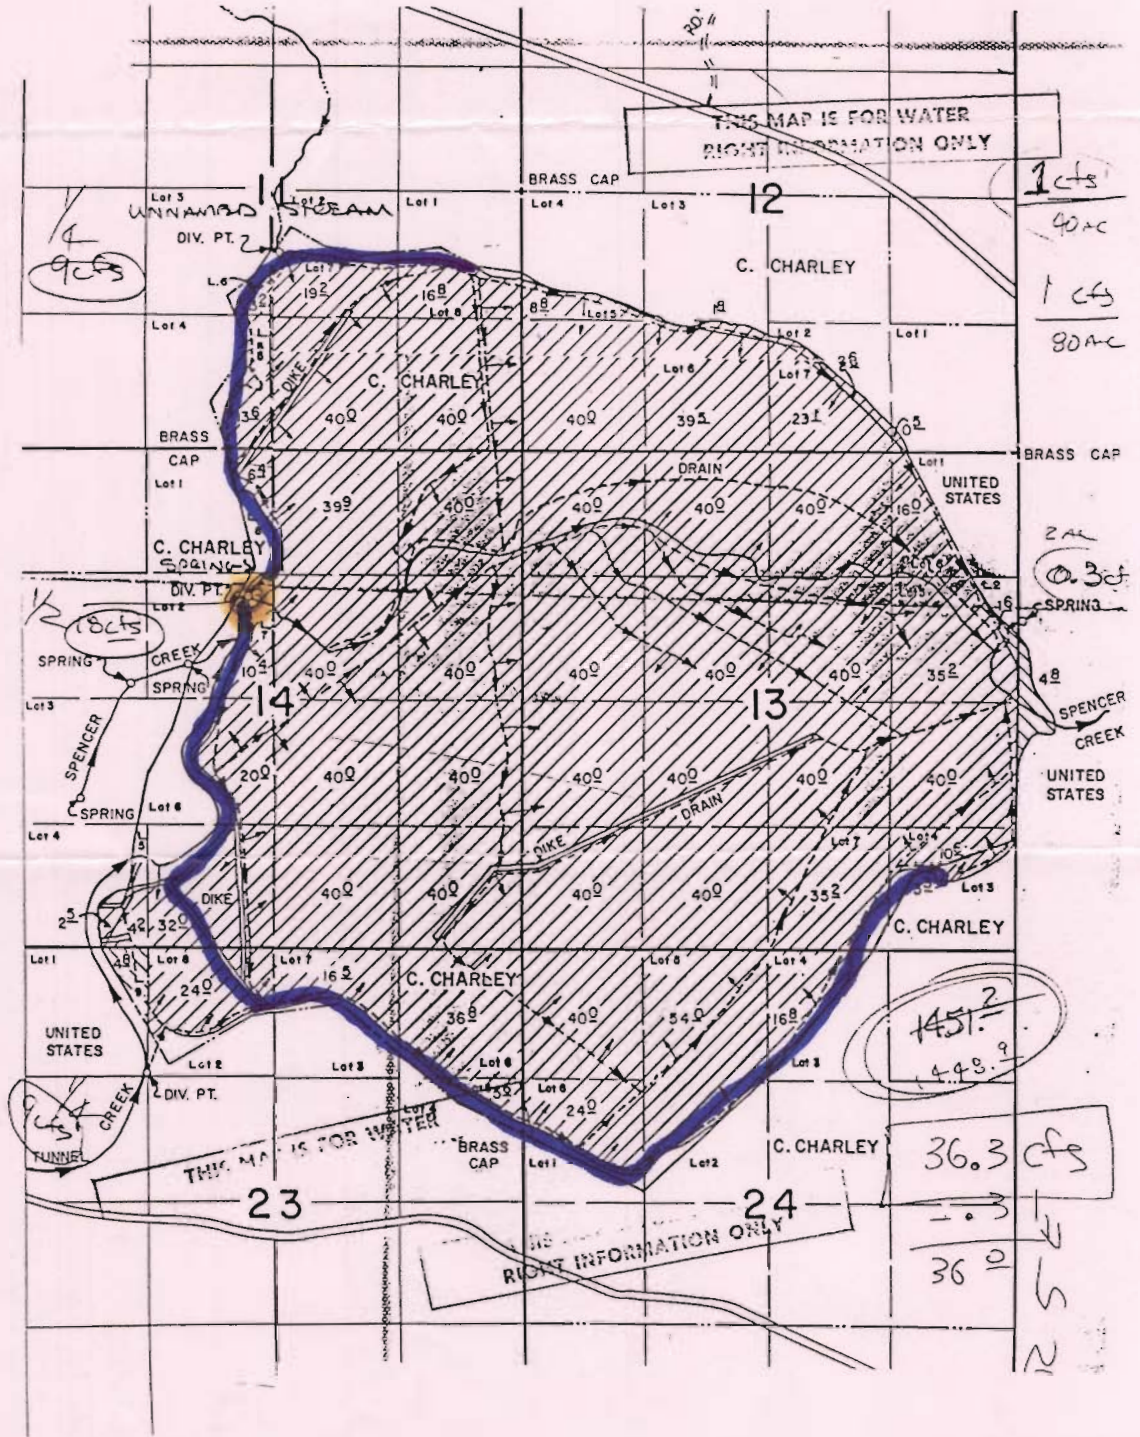

145.2
448.9

36.3 cfs

36.0

1 cfs
40 ac
1 cfs
80 ac

2 ac
0.3 cfs

5
N