


T.40S., R.8E., W.M.

KLAMATH ADJUDICATION
CLAIM 201 PAGE # 51

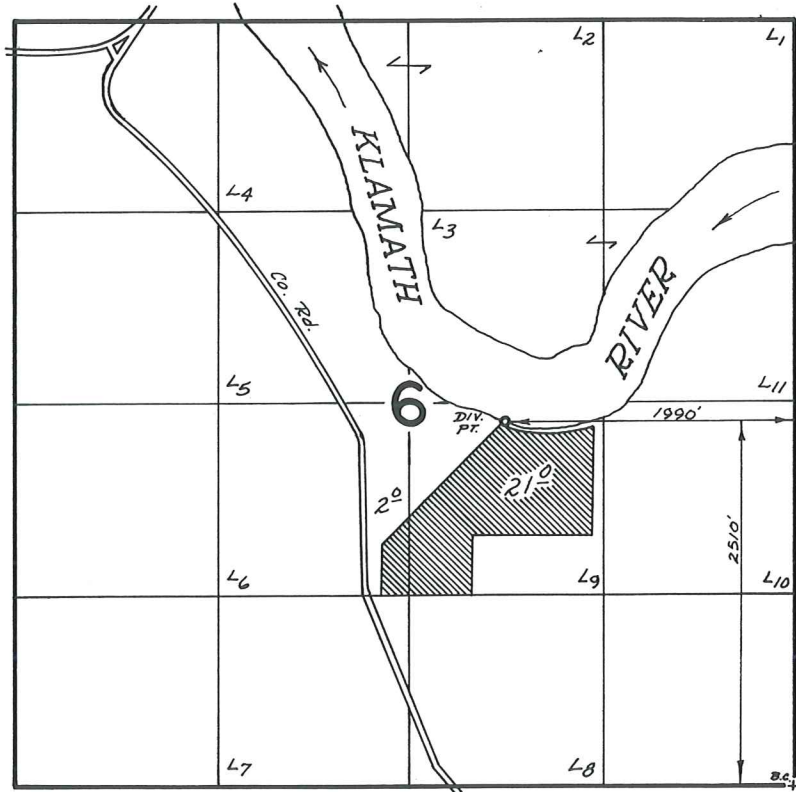

FINAL PROOF SURVEY
UNDER

Application No. 42790 Permit No. 3/991.....
IN NAME OF

RICHARD & JO ANNE BERG

Surveyed Oct. 19 1972, by D. Norby