


T.40S.,R.8E.,W.M.

KLAMATH ADJUDICATION

CLAIM # 206

PAGE # 23

Klamath River

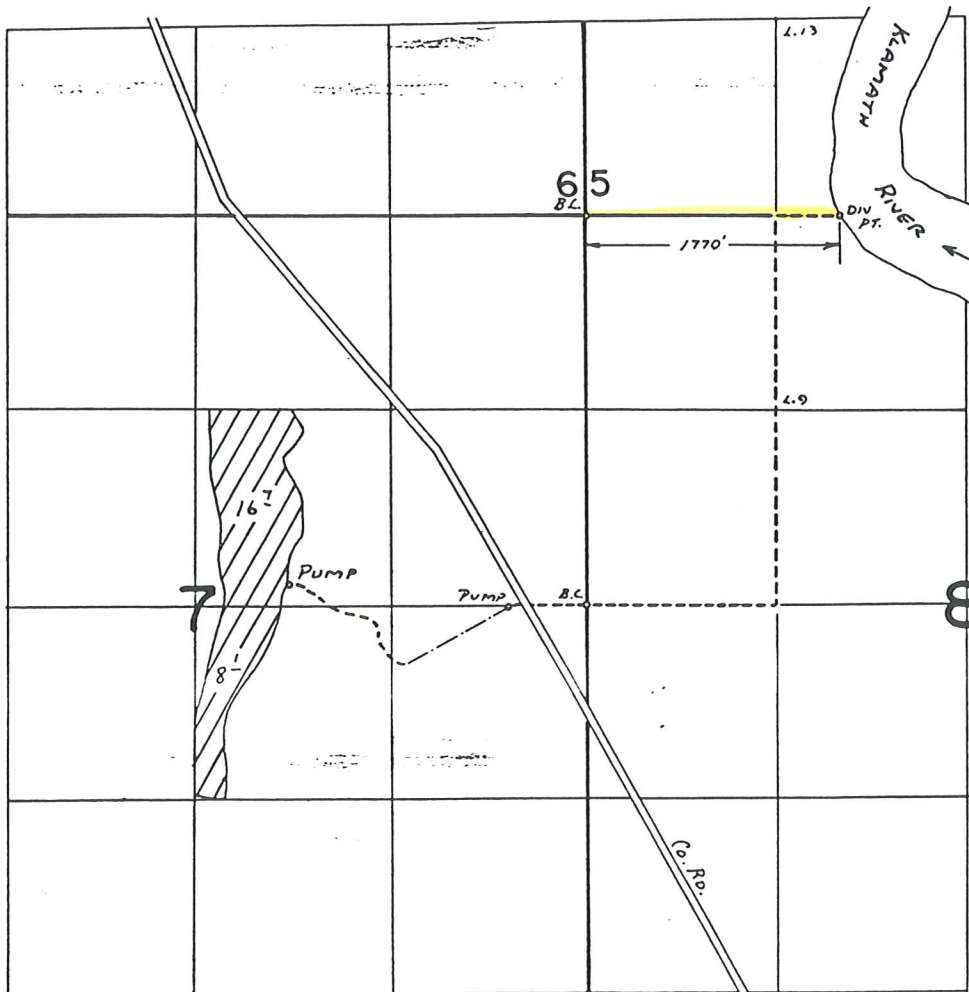

FINAL PROOF SURVEY UNDER

RECEIVED

DEC 14 1998

WATER RESOURCES DEPT. SALEM, OREGON

Application No. 46712 Permit No. 34908 IN NAME OF

LLOYD V. HOWARD

Surveyed July 15, 1975, by L. E. Gault