


T35S R6W Southwest Quarter

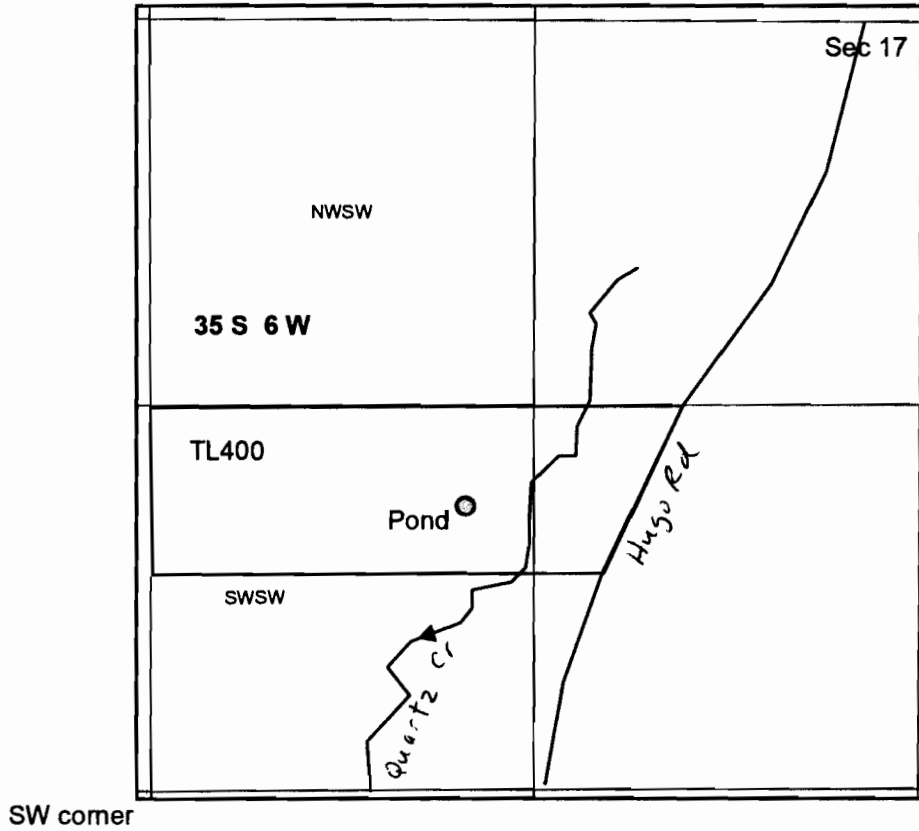

1 inch = 660 feet

Pond is 1076 feet east and
970 feet north from the
SW corner sec 17.

RECEIVED BY OWRD

SEP 26 2012

SALEM, OR

R-87841