


T. 41 S., R. 1 E., W. M.

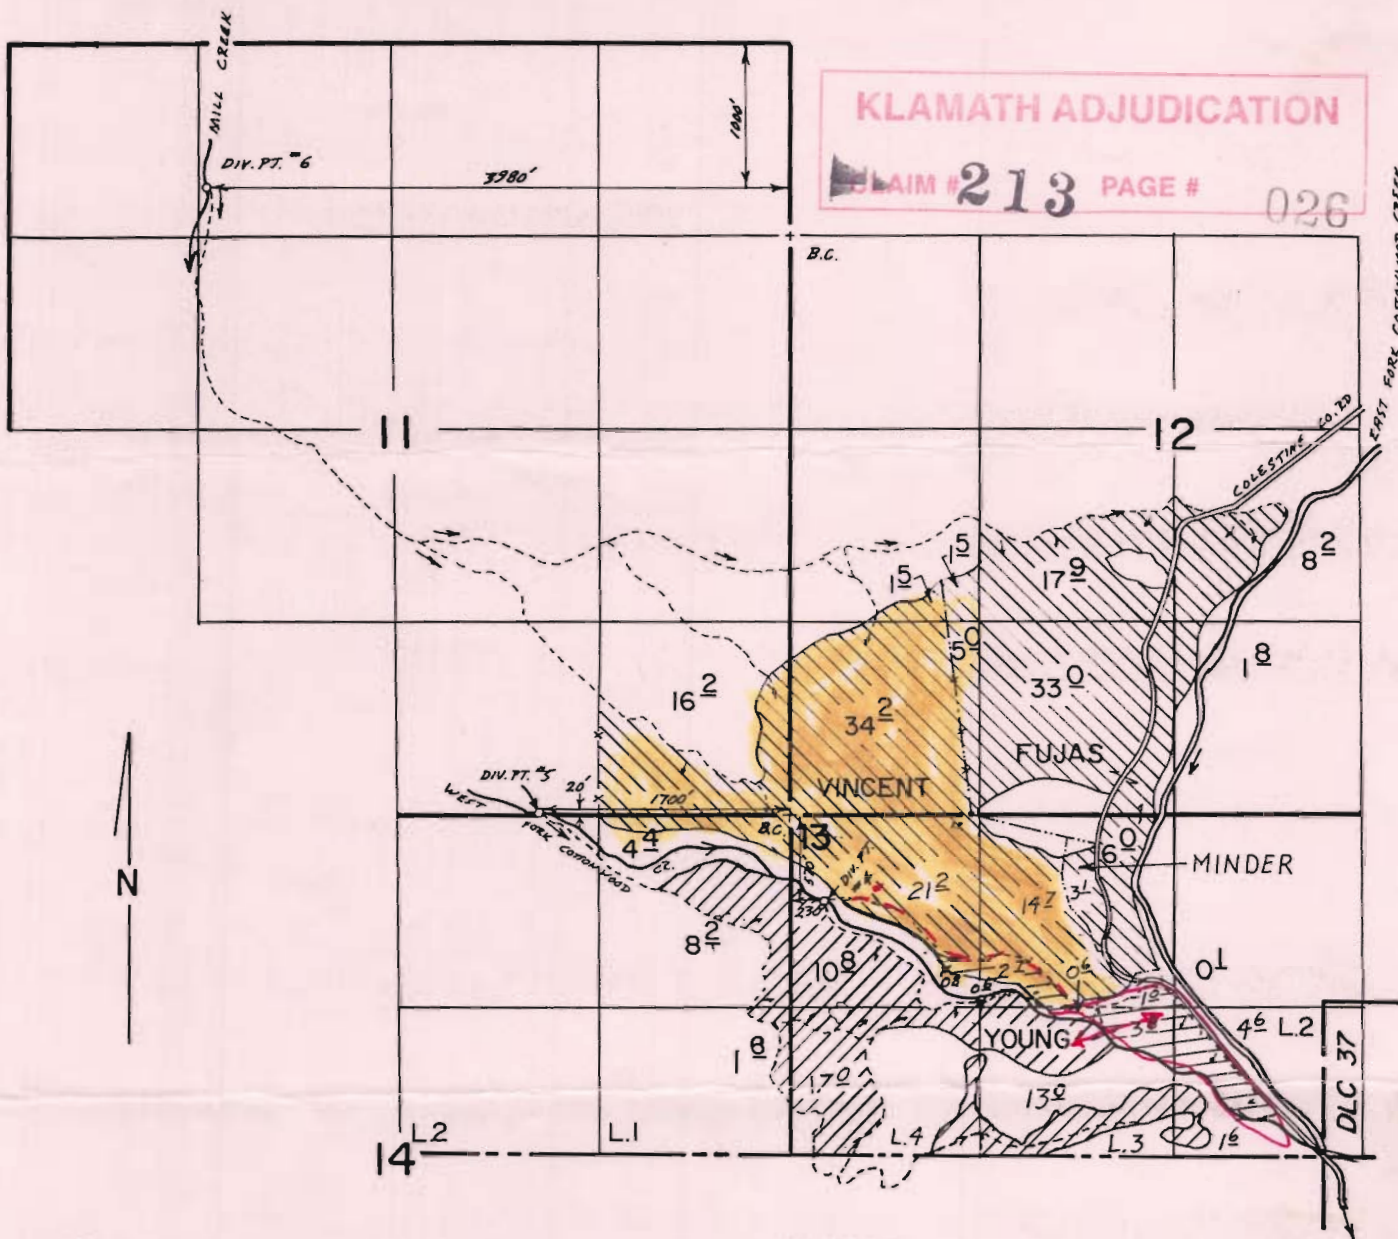

-  DIV. PT. 4
-  DIV. PT. 5
-  DIV. PT. 6

Scale 1" = 1320'

FINAL PROOF SURVEY

UNDER

Application No. 58955 Permit No. 44755
IN NAME OF

MINDER, YOUNG, VINCENT, & FUJAS

Surveyed Sept. 12, 18, 1985, by B.S. JAMES

*Young lower
10+ ac.
irrigated out
of Cottonwood
Creek - D. Point 4.*

Exhibit E