

T. 41 S., R. 1 E., W. M.


RECEIVED

JAN 28 1931

WATER RESOURCES DEPT.
SALEM, OREGON

KLAMATH ADJUDICATION

CLAIM # 214 PAGE # 014

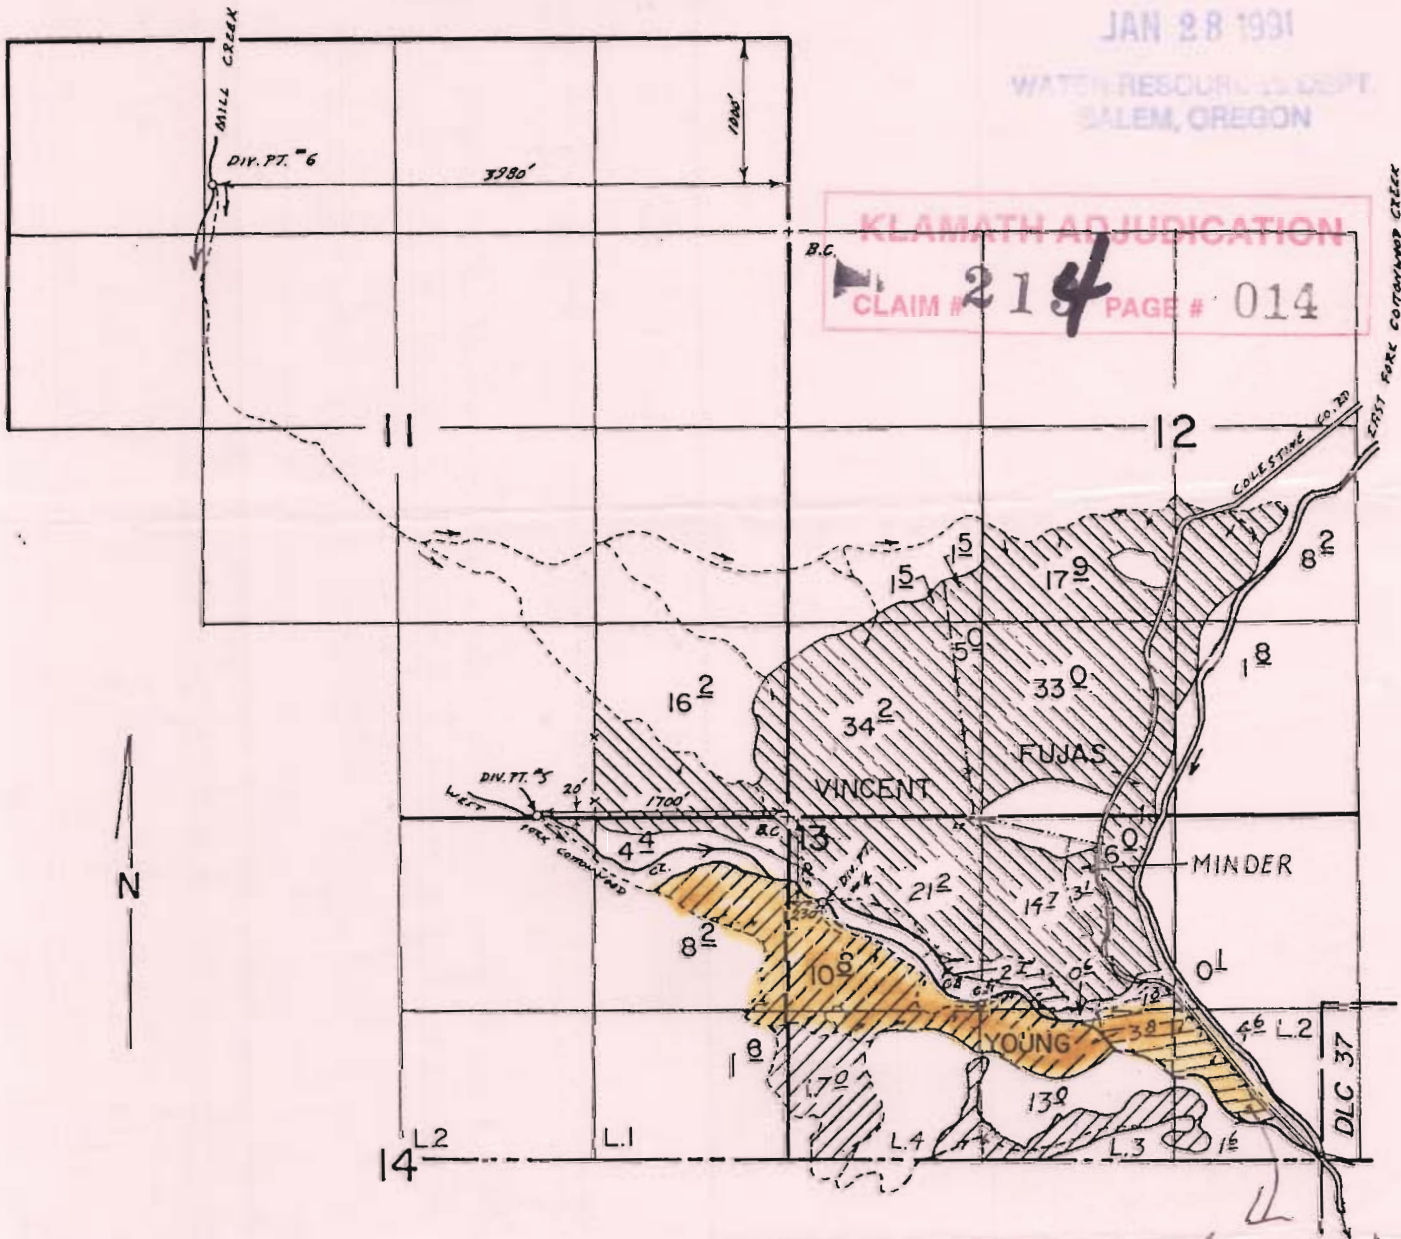

□ DIV. PT. 4

▨ DIV. PT. 5

▩ DIV. PT. 6

Scale 1" = 1320'

FINAL PROOF SURVEY UNDER

*All of this was irrigated
Before & after the War
Corp Ranch venture
& has been ever since.*

Application No. 58955. Permit No. 44755 ...
IN NAME OF

MINDER, YOUNG, VINCENT, & FUJAS

Surveyed Sept. 12, 18, 1985, by B.S. JAMES