

T.41S.,R.4E.,W.M.

SECTION COR.
BRASS DISK
WEST 1/16 COR.
1346.4'



RECEIVED


SEP 28 1999

WATER RESOURCES DEPT.
SALEM, OREGON

SCALE 1" = 400'

RECEIVED
SEP 28 1999

NOTE: MAP PREPARED FOR
WATER RIGHT PURPOSES ONLY,
NOT FOR PROPERTY BOUNDARY
LOCATIONS.

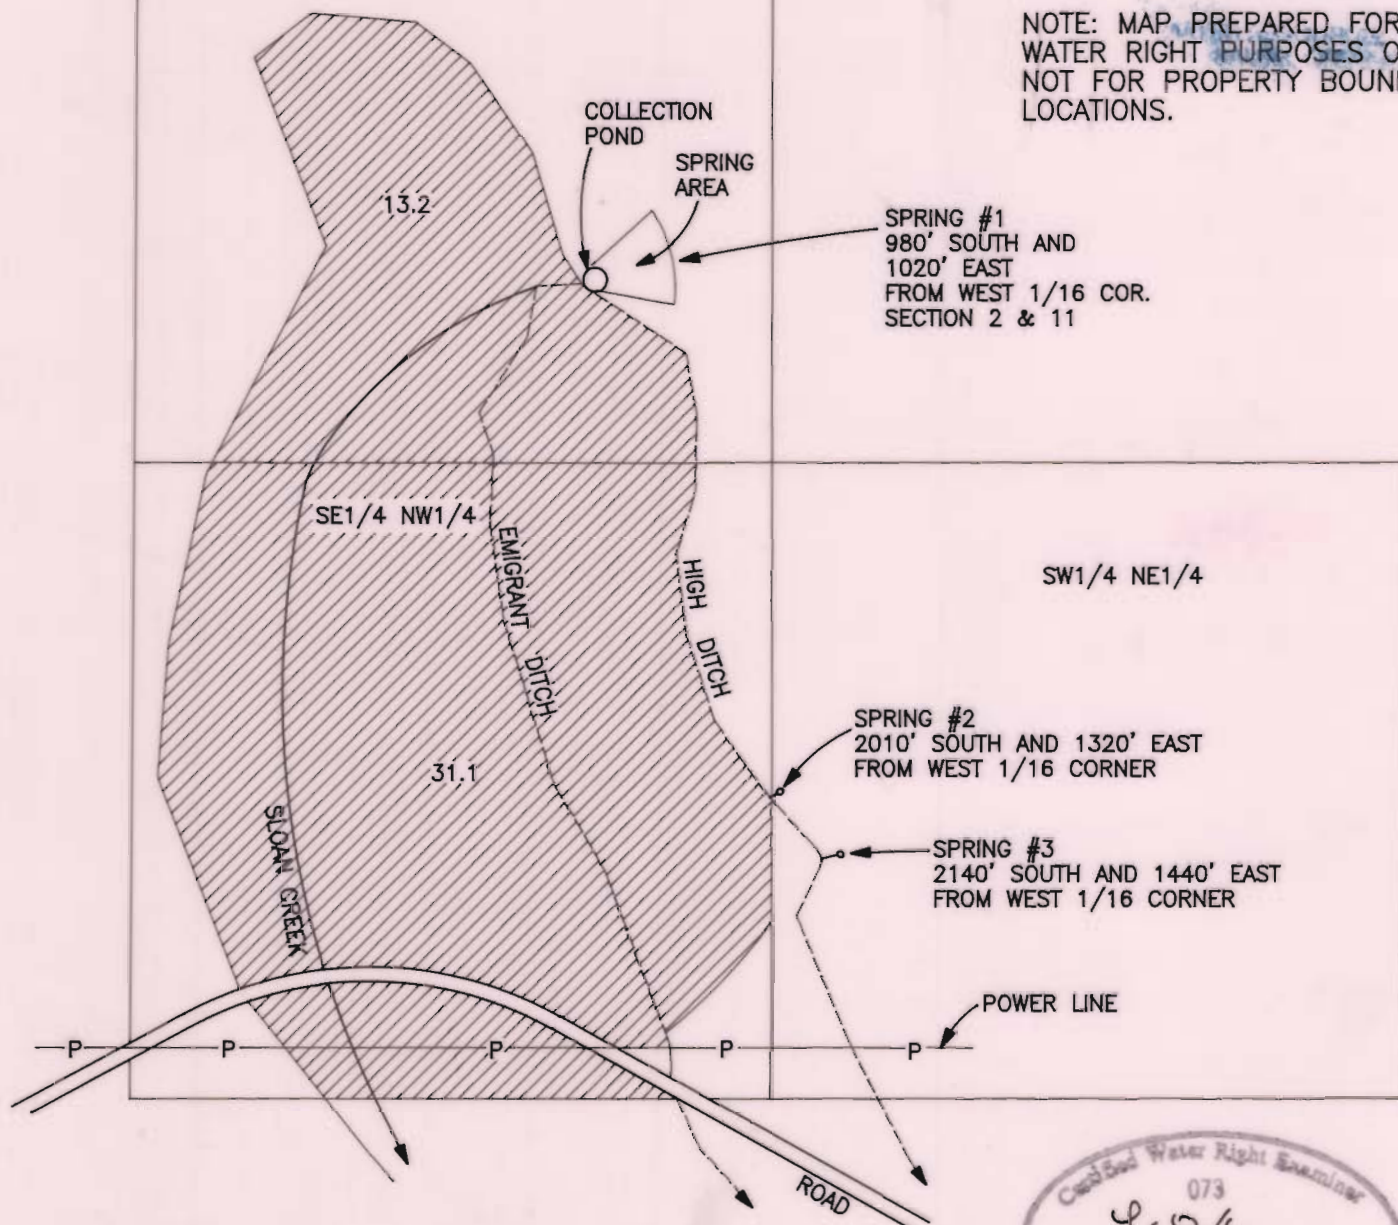


FINAL PROOF MAP

KLAMATH ADJUDICATION
CLAIM No. 215

IN THE NAME OF
JERRY BARRY

MAP PREPARED AUGUST 30, 1999 BY GARY D. KAISER

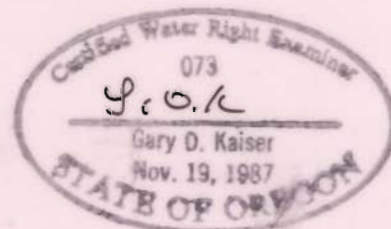

KLAMATH ADJUDICATION
CLAIM 215 PAGE 45