


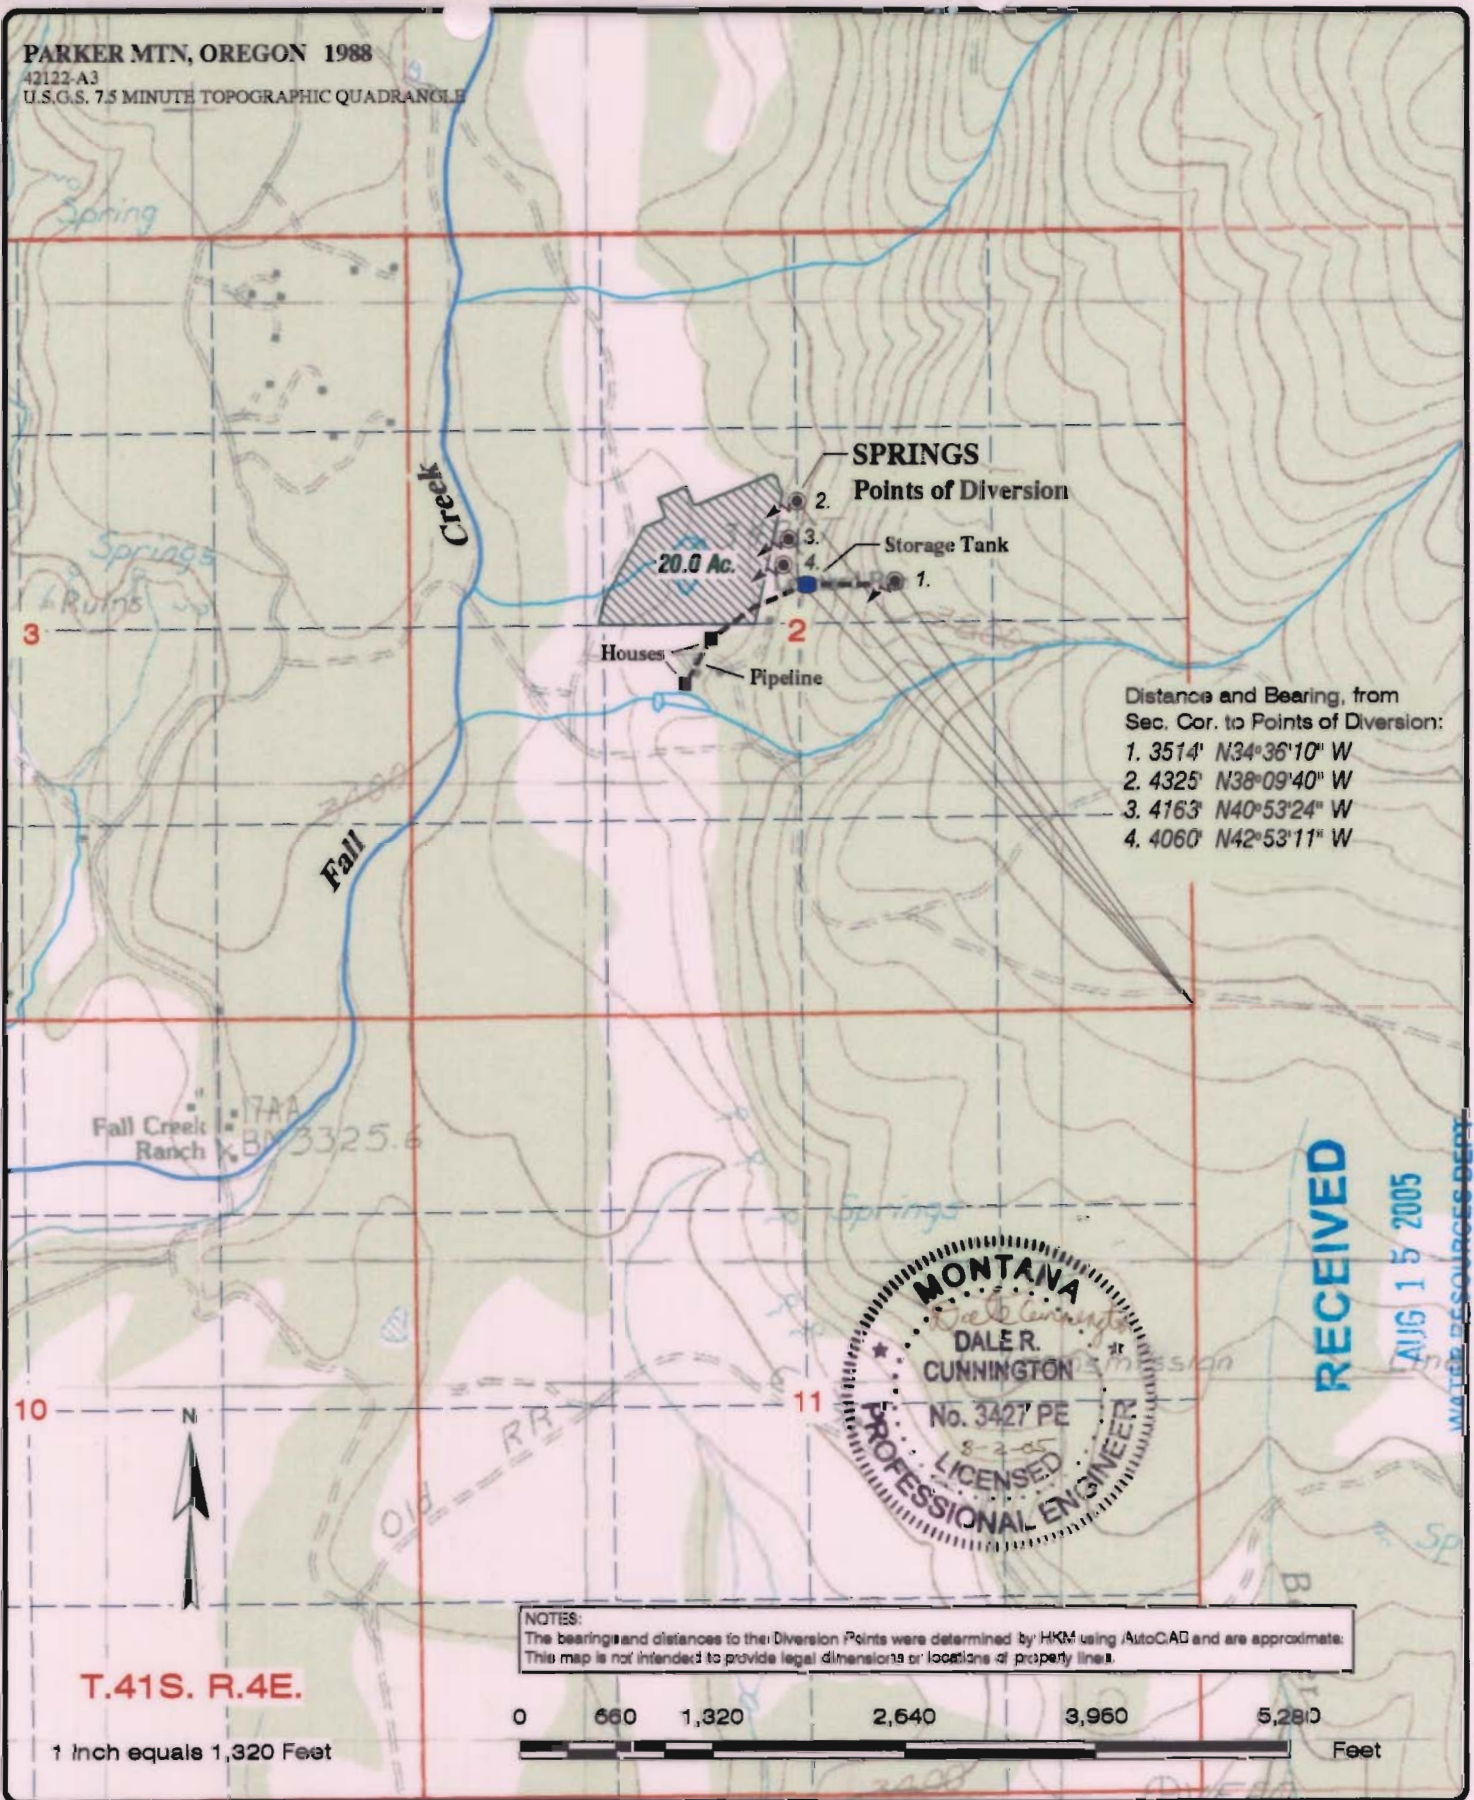

HKM Engineering Inc.
Granite Tower Building
222 N. 32nd St., Suite 700
P.O. Box 31318
Billings, MT 59107-1318
(406) 656-6399, FAX (406) 656-6398

KLAMATH BASIN WATER RIGHTS ADJUDICATION
CLAIM NO. 217 - SETTLEMENT
CLAIMANTS: TROUTMANS & GOLDMANS