



# TOWNSHIP 34 SOUTH, RANGE 8 EAST, W. M.

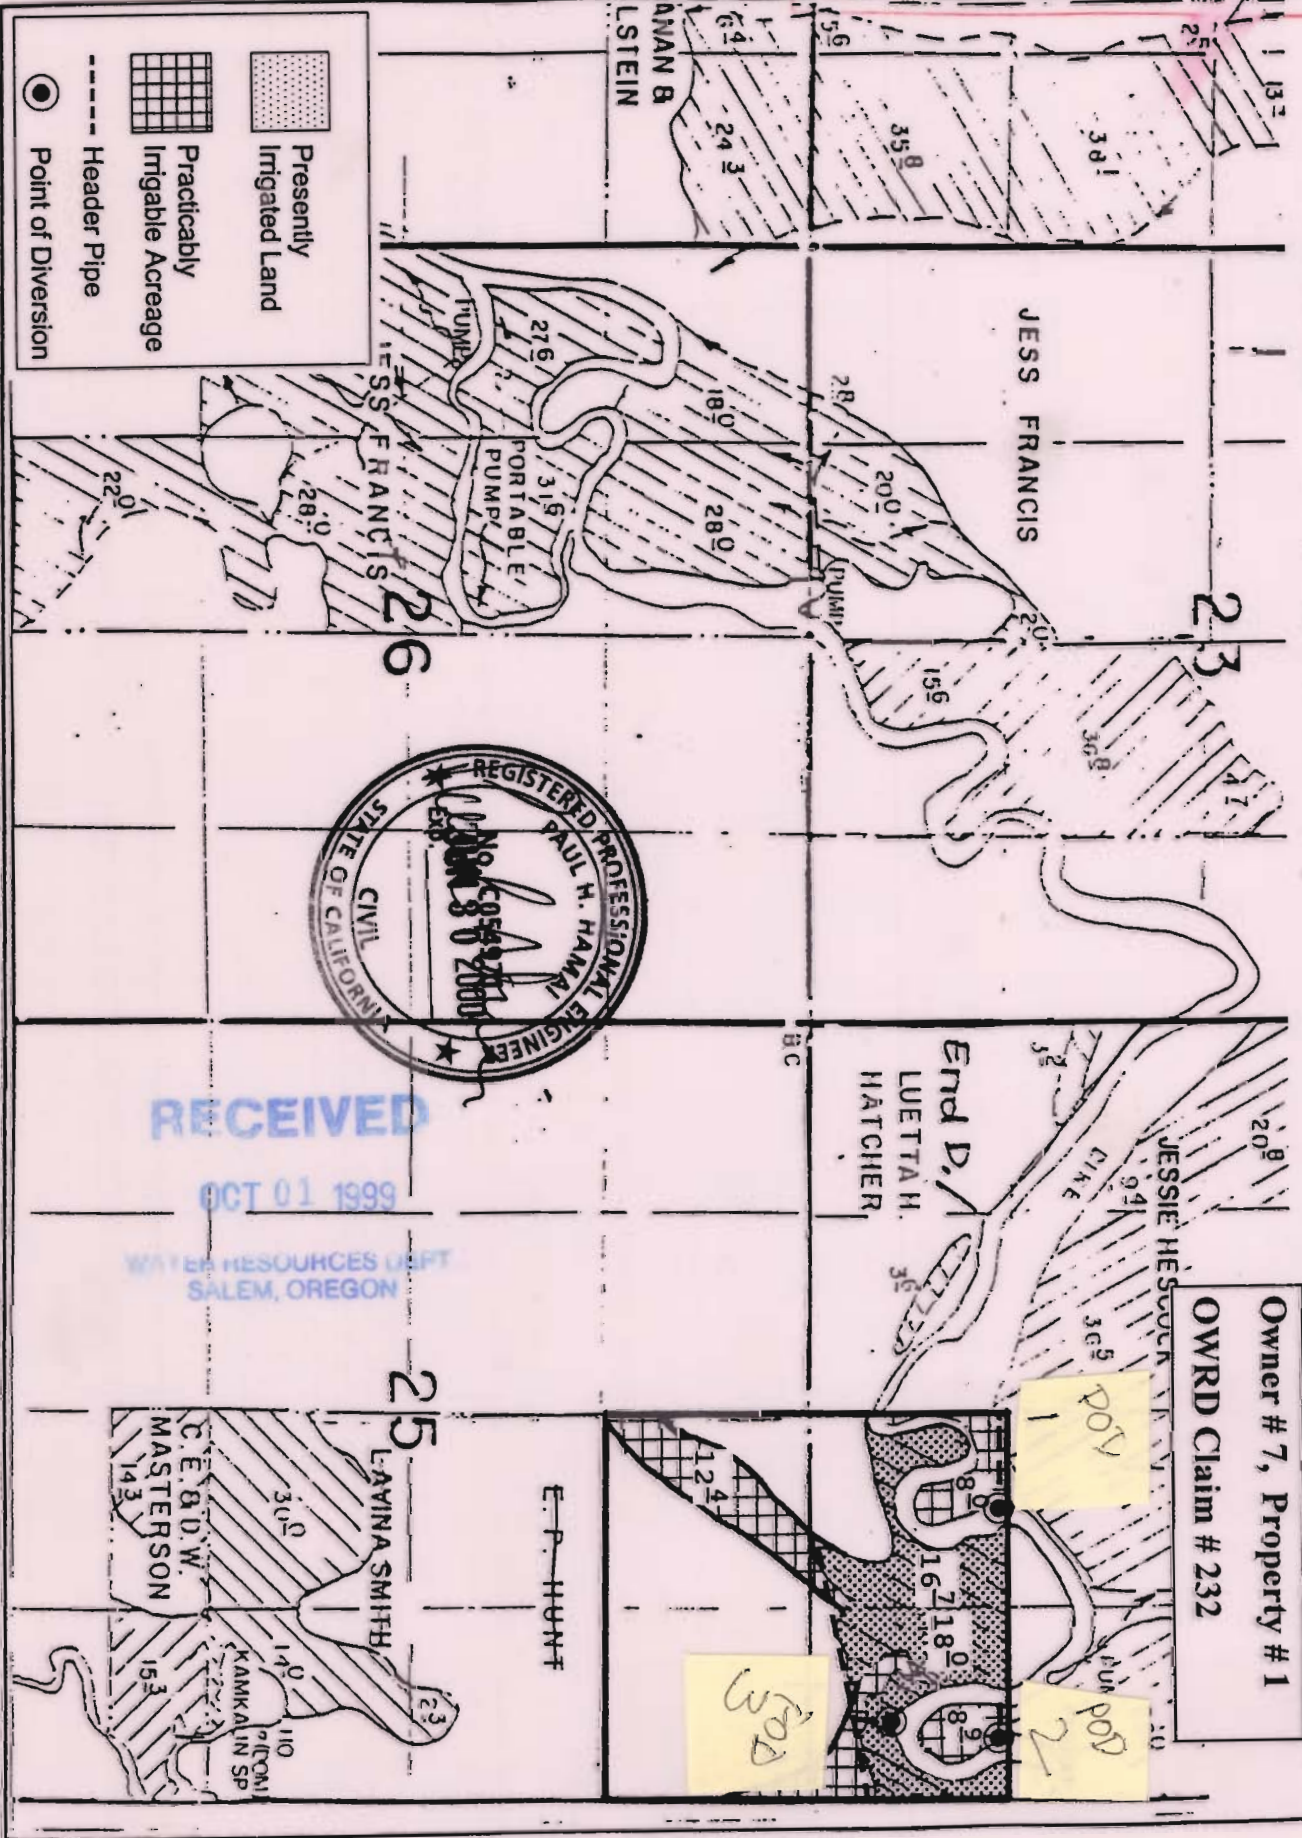

Owner # 7, Property # 1  
 OWRD Claim # 232

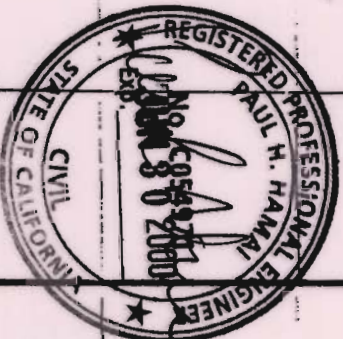

RECEIVED

OCT 01 1999

WATER RESOURCES DEPT  
 SALEM, OREGON

By: Natural Resources Consulting Engineers Inc.  
 1250 Addison St., Suite 204  
 Berkeley, Ca. 94702  
 Berkeley (510)841-7814

