



Oregon Water Resources Department
 725 Summer Street NE, Suite A
 Salem, Oregon 97301
 (503) 986-0900
 www.wrd.state.or.us

Request for Assignment

If for multiple rights, a separate form and fee for each right will be required.

I, Jack and Sally Hay

(Name of Applicant / Permit / Transfer Holder / License Holder/GR Certificate of Registration)

4455 Emerson Loop Road The Dalles OR 97058 541-340-9265
 (Mailing Address) (City) (State) (Zip) (Phone #)

- hereby assign all my interest in and to application/permit/transfer/license/GR Certificate of Registration;
- hereby assign all my interest in and to a portion of application/permit/transfer/license/GR Certificate of Registration; (You must include a map showing the portion of the application/permit/transfer/license/GR Certificate of Registration to be assigned.)
- hereby assign a portion of my interest in and to the entire application/permit/transfer/license/GR Certificate of Registration:

Application # G-16685 ; Permit # G-16235 ; Transfer # _____
 -OR-

License # _____ ; GR Statement # _____ ; GR Certificate of Registration # _____

As filed in the office of the Water Resources Director, to:

Middlebay LTD. C/O James Martin, Sunshine Mill
 (Name of New Owner)

901 E 2nd Street The Dalles OR 97058
 (Mailing Address) (City) (State) (Zip) (Phone #)

Note: If there are other owners of the property described in the Application, Permit, Transfer, License, or GR Certificate of Registration, you must provide a list of all other owners' names and mailing addresses and attach it to this form.

I hereby certify that I have notified all other owners of the property described in this Application, Permit, Transfer, License, or GR Certificate of Registration of this Request for Assignment

Witness my hand this 26th day of June, 2012

Applicant/Permit Holder X [Signature]

Applicant/Permit Holder X [Signature]

ASS (6/21/12) J.M. 6/28/2012

DO NOT WRITE IN THIS BOX

This certifies assignment and record change at Oregon Water Resources Department effective 8:00 a.m. on date of receipt at Salem, Oregon.

Fee receipt # 106132
 For Director by Jerry Sauter, Program Analyst in Water Rights Division [Signature]

The completed "Request for Assignment" form *must* be submitted to the Department along with the recording fee of \$75.

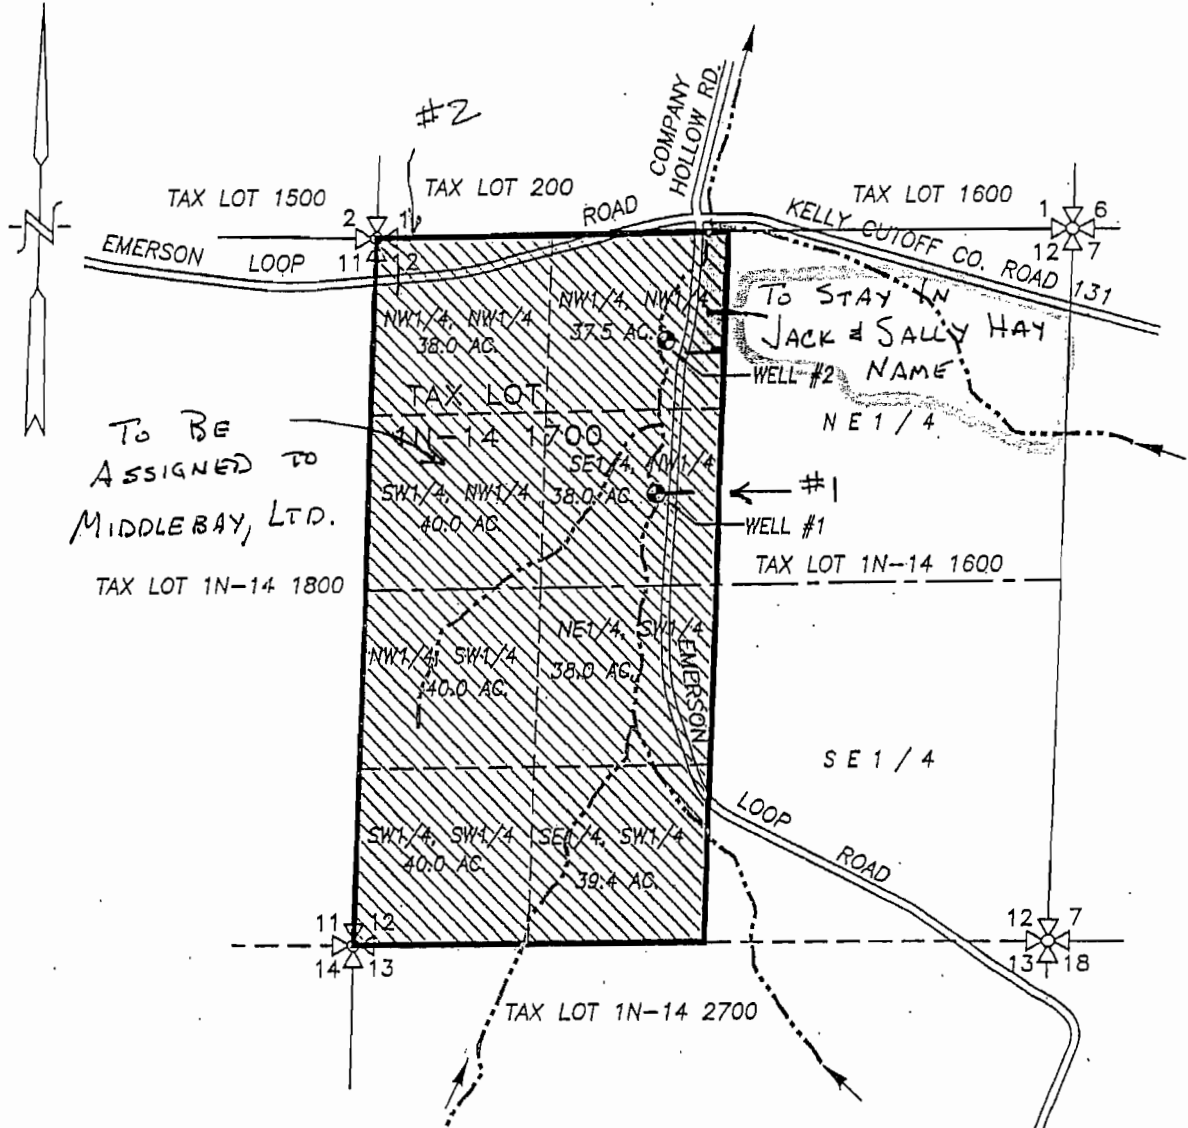
RECEIVED

JUN 28 2012



WR

WATER RESOURCES DEPT
 SALEM, OREGON

SECTION 12, TWP.1 N. RANGE 14 E. W.M.
 WASCO COUNTY, OREGON



LEGEND:

- EXISTING WELL #1 AND NEW WELL #2
 WELL #1 = 1,910' S. & 2,140' E. OF NW COR. SECTION 12
 WELL #2 = 775' S. & 2,180' E. OF NW COR. SECTION 12
-  PROPOSED APPLICATION AREA = 310.9 ACRES
-  IRRIGATION MAIN

WATER RIGHT APPLICATION MAP

RECEIVED

SCALE: 1" = 1320'

APPLICATION NO. *6-1185*

JUN 28 2012

WATER RESOURCES DEPT
 SALEM, OREGON