


Water Right Application Map

* MAP MADE
BY DISTRICT 11
WATERMASTER,
JEREMY GIFFIN

T 12 S R 15 E Section 34 WM

▨ - Area to be
Irrigated

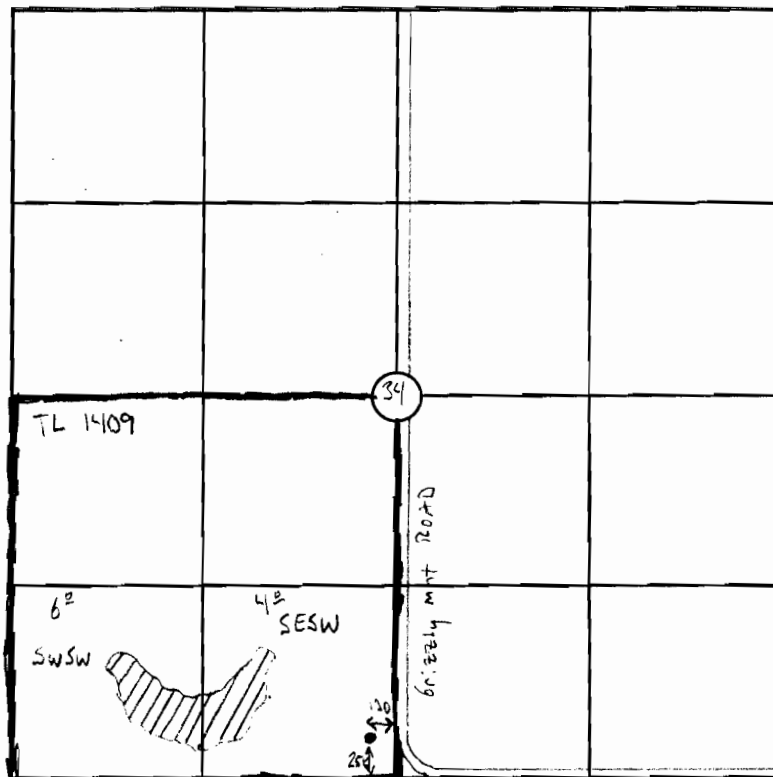

1 inch = 1320 feet

0 0.125 0.25 0.5
Miles

Well Location: 250 Feet (N, S)
and 130 Feet (E , W) of S 1/4 Corner
of Section 34 of Township 12 South
Range 15E, W.M.

RECEIVED BY OWRD

OCT 15 2012

Applicaion Map
IN NAME OF:

SALEM, OR

DAVID SHEETS

Date: 9-26-12

Staff Initials: JG



G-17590