TOWNSHIP 35 SOUTH, RANGE 12 EAST, W. M.

Owner # 49A, Property #1

OWRD Claim # 278

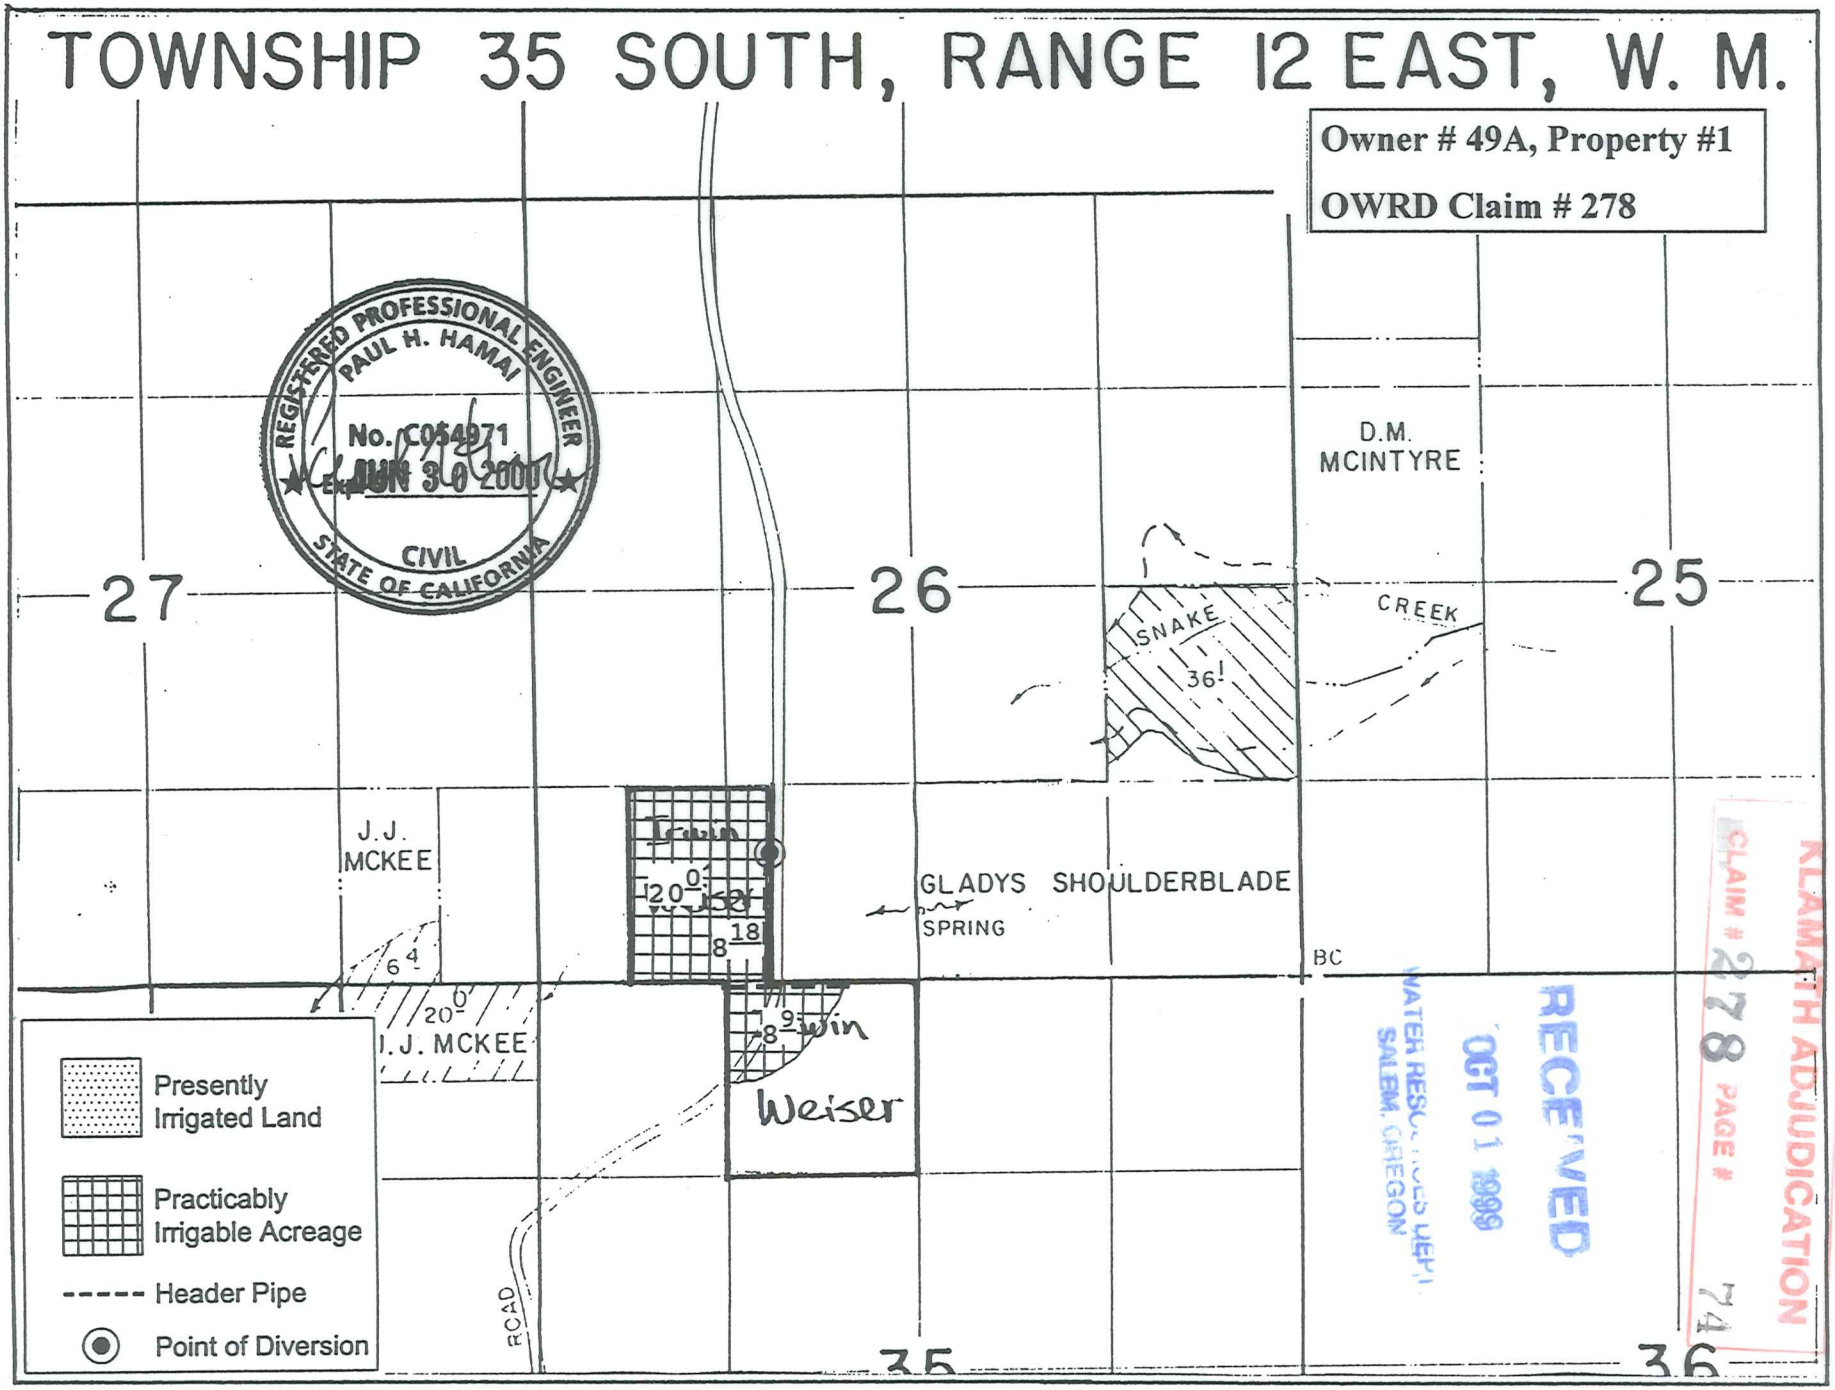

RECEIVED
OCT 01 1999
WATER RESOURCES DEPT
SALEM, OREGON

KLAMATH ADJUDICATION
CLAIM # 278 PAGE # 74

By: Natural Resources Consulting Engineers Inc.
1250 Addison St., Suite 204
Berkeley, Ca. 94702
Berkeley (510)841-7814

NRCE