


T. 40 S., R. 3 E., W.M.

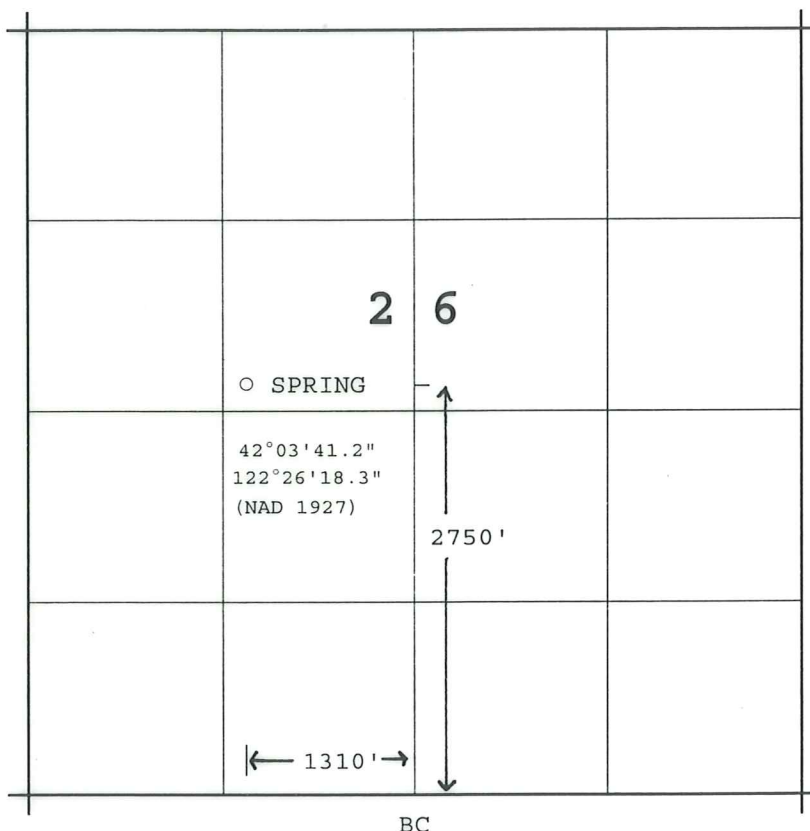

N



1 IN. = 1320 FT.

40326-2 SPRING

IN NAME OF

UNITED STATES BUREAU OF LAND MANAGEMENT

MEDFORD DISTRICT

FOR

FEDERAL RESERVED RIGHTS



THE PURPOSE OF THIS MAP IS FOR IDENTIFYING THE LOCATION OF THE WATER RIGHT ONLY AND IS NOT INTENDED TO PROVIDE LEGAL DIMENSIONS OR LOCATION OF PROPERTY OWNERSHIP LINES.

BLM PROJECT NO. 40326-2

SITE VISITED: JUNE 4, 1997

U.S. BUREAU OF LAND MANAGEMENT - OSO
BRANCH OF GEOGRAPHIC SCIENCE
LETTER OF AUTHORIZATION
DATED: MARCH 3, 1997

EXECUTED BY:
DANIEL E. WELLER, PLS, CWRE
OR-957.1
P.O. BOX 2965
PORTLAND OR., 97208

CLAIM 330

CLAIM # 330 PAGE 12