


15 14
22 23 sections

Well is located from
NE corner of section 22:

- 2230 ft south
- 1230 ft west

NE 1/4 NE 1/4

Section 22 T5S R3W W.M.
Yamhill County, Oregon

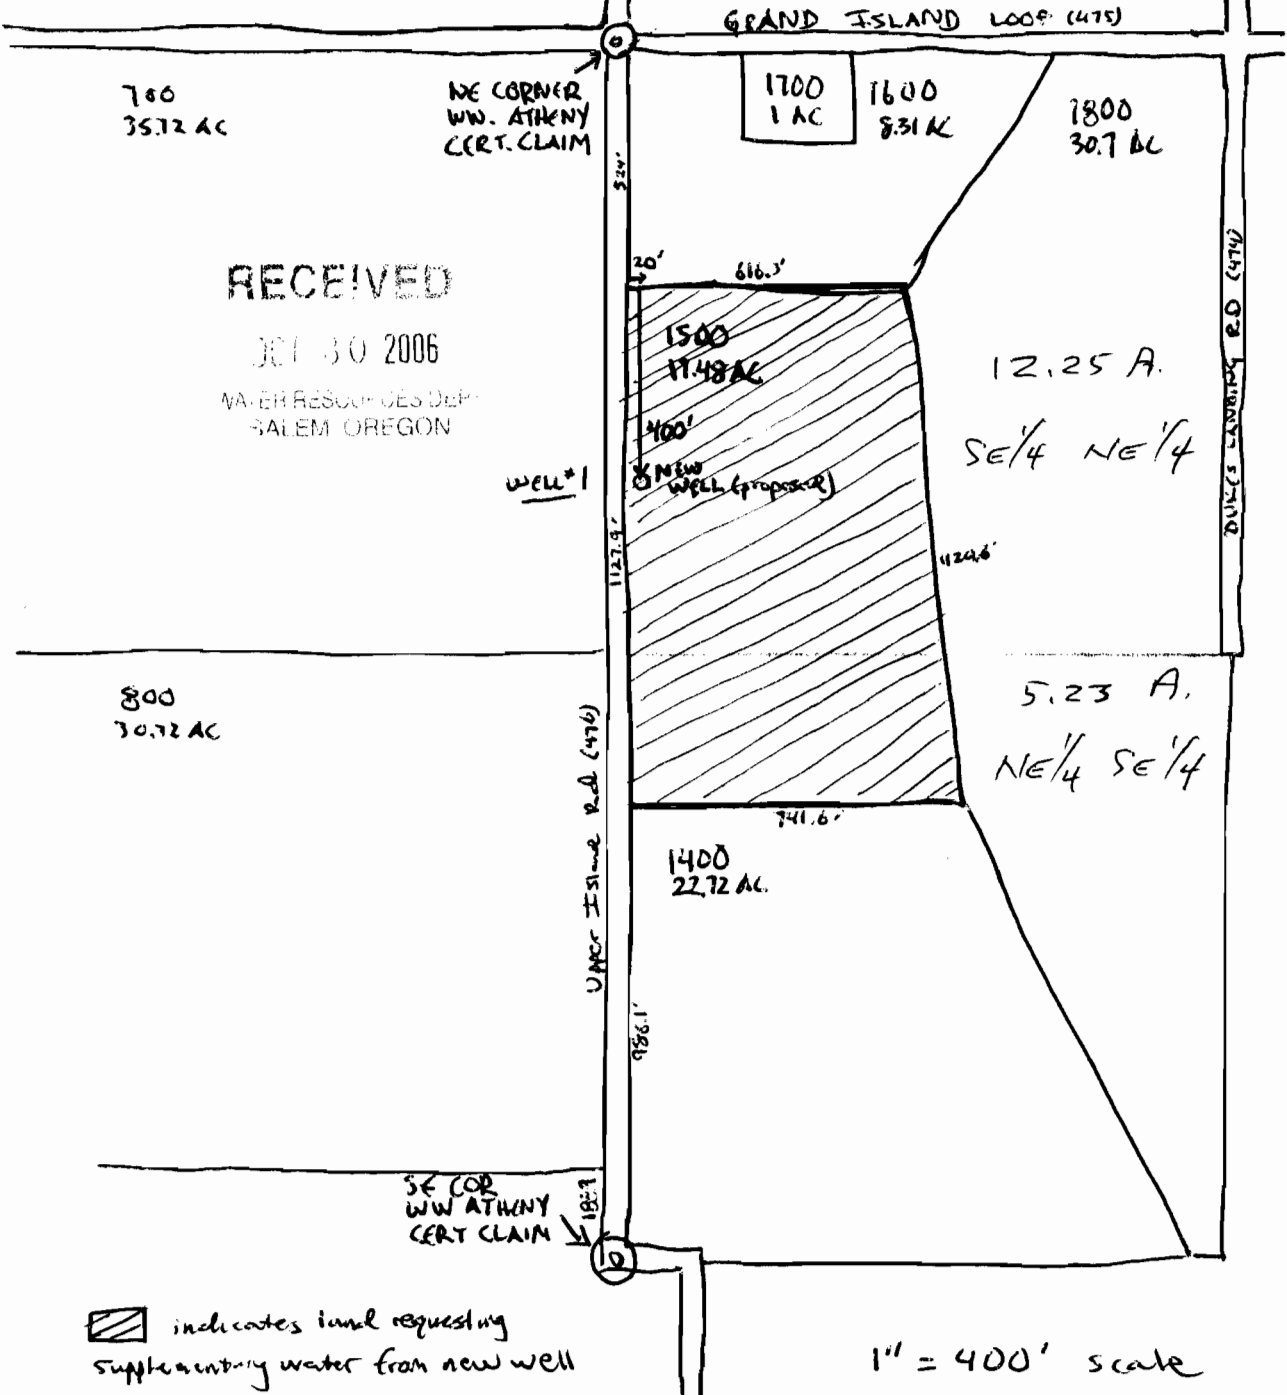

indicates land requesting
supplementary water from new well

APPLICATION MAP for WATER RIGHT: CASEY KULLA, APPLICANT 10-30-06
TRACT 5-3-22-01500, in SE 1/4 NE 1/4