


T. 23 S. R. 32 1/2 E. Section 23 S.E. 1/4
TAX Lots 3200 AND 3200

↑ N

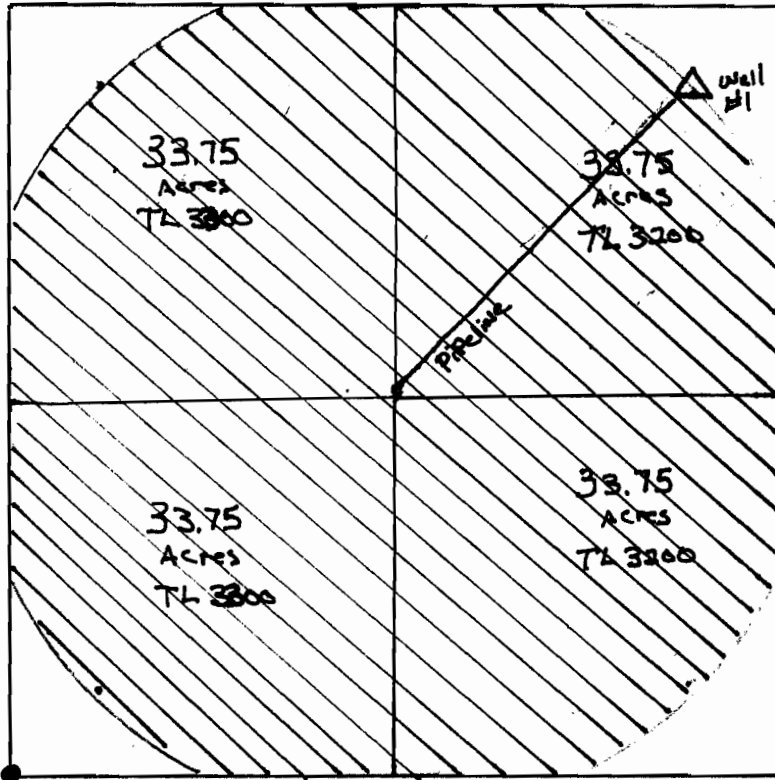

Scale 1" = 660'

Well: 2352' East
2352' North of
SW corner Section
23

Found Property corner
SW corner of S.E. 1/4 Section 23

Don Nienke

T. 23 S. R. 32 1/2 E. Section 23 S.E. 1/4

RECEIVED BY OWRD

OCT 29 2012


SALEM, OR

G-17593


THIS MAP WAS PREPARED FOR ASSESSMENT PURPOSE ONLY

T.23S. R.32 1/2E. W.M.
HARNEY COUNTY
1" = 2000'

23S 32VE
& INDEX

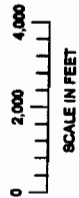

SEE MAP 228 32VE

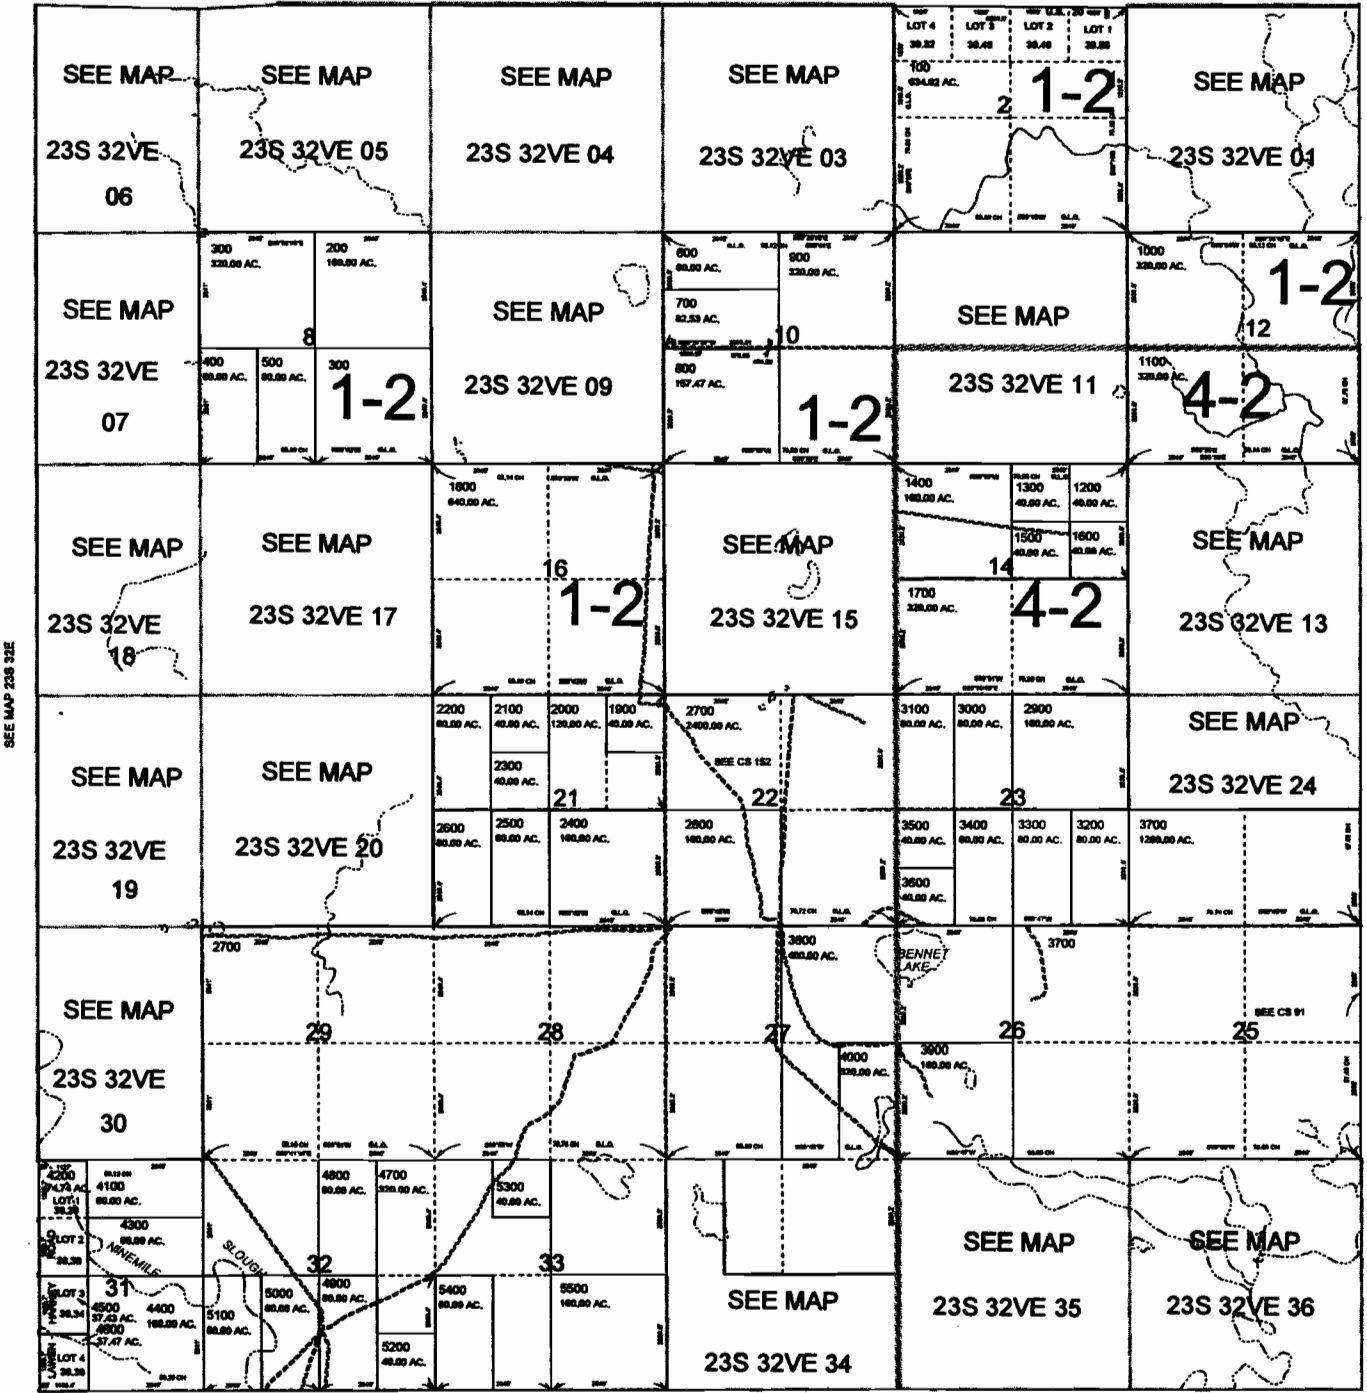

- CANCELLED NO.
- 400M1
 - 400M2
 - 500M1
 - 500M2
 - 600M1
 - 600M2
 - 700M1
 - 700M2
 - 800M1
 - 800M2
 - 900M1
 - 900M2
 - 1000M1
 - 1000M2
 - 1100M1
 - 1100M2
 - 1200M1
 - 1200M2
 - 1300M1
 - 1300M2
 - 1400M1
 - 1400M2
 - 1500M1
 - 1500M2
 - 1600M1
 - 1600M2
 - 1700M1
 - 1700M2
 - 1800M1
 - 1800M2
 - 1900M1
 - 1900M2
 - 2000M1
 - 2000M2
 - 2100M1
 - 2100M2
 - 2200M1
 - 2200M2
 - 2300M1
 - 2300M2
 - 2400M1
 - 2400M2
 - 2500M1
 - 2500M2
 - 2600M1
 - 2600M2
 - 2700M1
 - 2700M2
 - 2800M1
 - 2800M2
 - 2900M1
 - 2900M2
 - 3000M1
 - 3000M2
 - 3100M1
 - 3100M2
 - 3200M1
 - 3200M2
 - 3300M1
 - 3300M2
 - 3400M1
 - 3400M2
 - 3500M1
 - 3500M2
 - 3600M1
 - 3600M2
 - 4200M1
 - 4400M1
 - 4400M2
 - 4500M1
 - 4500M2
 - 4600M1
 - 4600M2
 - 4700M1
 - 4700M2
 - 4800M1
 - 4800M2
 - 4900M1
 - 4900M2
 - 5000M1
 - 5000M2
 - 5100M1
 - 5100M2
 - 5200M1
 - 5200M2
 - 5300M1
 - 5300M2
 - 5400M1
 - 5400M2

RECEIVED BY OWRD

OCT 29 2012

SALEM, OR

G-17593

SEE MAP 238 32E

SEE MAP 238 33E

SEE MAP 248 32VE

PRINTED ON
Jul 06, 2005
23S 32VE
& INDEX