


T. 41 S., R. 3 E., W.M.

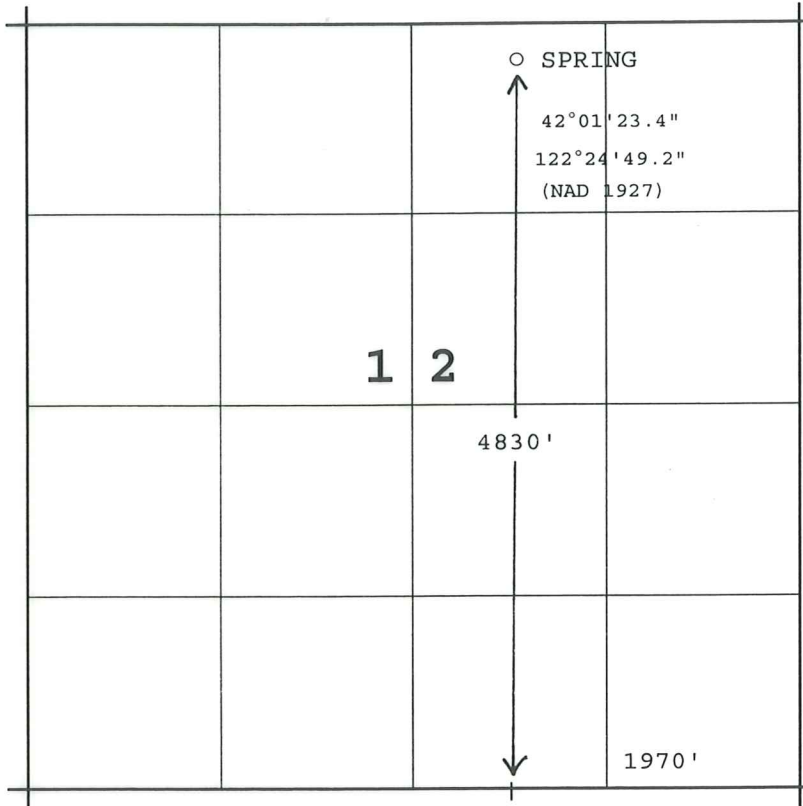

1 IN. = 1320 FT.

BC



### BIG POWERLINE SPRING

IN NAME OF

UNITED STATES BUREAU OF LAND MANAGEMENT,

MEDFORD DISTRICT

FOR

### FEDERAL RESERVED RIGHTS



THE PURPOSE OF THIS MAP IS FOR IDENTIFYING THE LOCATION OF THE WATER RIGHT ONLY AND IS NOT INTENDED TO PROVIDE LEGAL DIMENSIONS OR LOCATION OF PROPERTY OWNERSHIP LINES.

BLM PROJECT NO. BIG POWERLINE

SITE VISITED: MAY 21, 1997

U.S. BUREAU OF LAND MANAGEMENT - OSO  
BRANCH OF GEOGRAPHIC SCIENCE  
LETTER OF AUTHORIZATION  
DATED: MAY 15, 1997

EXECUTED BY:  
DANIEL E. WELLER, PLS, CWRE  
OR-957.1  
P.O. BOX 2965  
PORTLAND OR., 97208

CLAIM 366

