

T. 41 S., R. 2 E., W.M.

		2850'	BC
	SPRING ○ -410' 42°01'25.5" 122°34'19.2" (NAD 1927)		
	1 0		



1 IN. = 1320 FT.

RECEIVED
 AUG 30 1999
 WATER RESOURCES DEPT
 SALEM, OR

OAK GROVE SPRING


IN NAME OF

UNITED STATES BUREAU OF LAND MANAGEMENT

MEDFORD DISTRICT

FOR

FEDERAL RESERVED RIGHTS

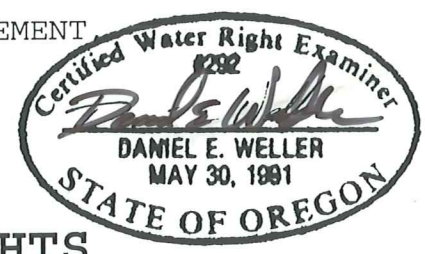

THE PURPOSE OF THIS MAP IS FOR IDENTIFYING THE LOCATION OF THE WATER RIGHT ONLY AND IS NOT INTENDED TO PROVIDE LEGAL DIMENSIONS OR LOCATION OF PROPERTY OWNERSHIP LINES.

BLM PROJECT NO. OAK GROVE

SITE VISITED: MAY 20, 1997

U.S. BUREAU OF LAND MANAGEMENT - OSO
 BRANCH OF GEOGRAPHIC SCIENCE
 LETTER OF AUTHORIZATION
 DATED: MAY 15, 1997

EXECUTED BY:
 DANIEL E. WELLER, PLS, CWRE
 OR-957.1
 P.O. BOX 2965
 PORTLAND OR., 97208

CLAIM 369

KLAMATH ADJUDICATION
 CLAIM 369 PAGE # 7