


T. 37 S., R. 14 E., W.M.

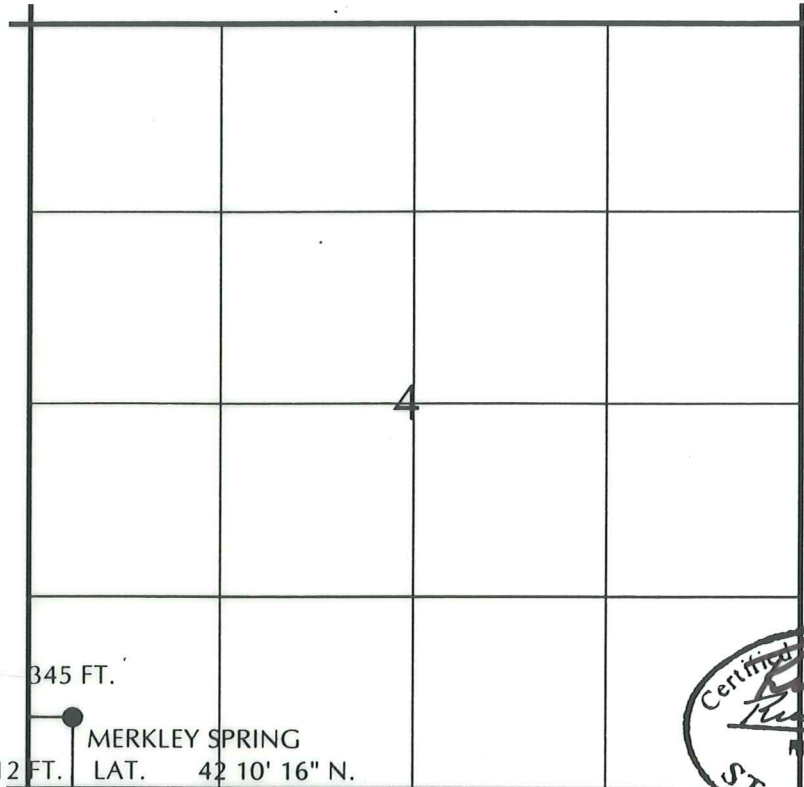

N



1 IN. = 1320 FT.

345 FT.

512 FT.

MERKLEY SPRING
LAT. 42° 10' 16" N.

GCDB COOR. LONG. 121° 07' 38" W. (NAD-27)

(NAD-27)

MERKLEY SPRING

IN NAME OF

UNITED STATES BUREAU OF LAND MANAGEMENT,
LAKEVIEW DISTRICT

FOR

FEDERAL RESERVED RIGHTS

JULY 12, 1993

BLM PROJECT NO. 59-4794

WRE 6245FRR, OREGON

THE PURPOSE OF THIS MAP IS FOR IDENTIFYING THE LOCATION OF THE WATER RIGHT AND
IS NOT INTENDED TO PROVIDE LEGAL DIMENSIONS OR LOCATION OF PROPERTY OWNERSHIP.

THE TIE WAS DETERMINED BY INVERSE BETWEEN A POSITION, THE SPRING, SCALED FROM THE BLY, OREGON,
PROVISIONAL QUADRANGLE, 1988 EDITION, AND A POSITION, FOR THE COR. OF SECS. 4, 5, 8 AND 9,
DERIVED FROM THE BLM GEOGRAPHIC COORDINATE DATA BASE(GCDB).

U.S. BUREAU OF LAND MANAGEMENT - OSO
BRANCH OF GEOGRAPHIC SCIENCE

LETTER OF AUTHORIZATION
DATED: JUNE 15, 1993

Claim 372

EXECUTED BY;
RICHARD L. JOHNSON, PLS, CWRE
OR-957.1
P.O. BOX 2965
PORTLAND, OR. 97208



4/1/97
8/27/99

KLAMATH ADJUDICATION

CLAIM # 372 PAGE # 7

