

T. 41 S., R. 5 E., W.M.

SPRING IS 137
FEET SOUTH AND
1108 FEET EAST
OF THE NW CORNER
OF SECTION 13.

B.C.

HAYDEN SPRING

NWNW

NENW

NWNE

NENE

LOT 4

LOT 3

LOT 2

LOT 1

OREGON
CALIFORNIA

HAYDEN SPRING

IN NAME OF

UNITED STATES BUREAU OF LAND MANAGEMENT

FOR

FEDERAL RESERVED RIGHTS


KLAMATH ADJUDICATION

CLAIM # 373 PAGE # 7



BLM PROJECT NO. 7U

SURVEYED: AUGUST 21, 1996

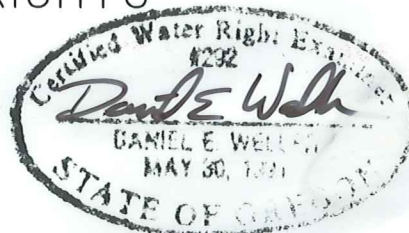

EXPIRES 6/30/00

THE PURPOSE OF THIS MAP IS FOR IDENTIFYING THE LOCATION OF THE WATER RIGHT ONLY AND IS NOT INTENDED TO PROVIDE LEGAL DIMENSIONS OR LOCATION OF PROPERTY OWNERSHIP LINES.

U.S. BUREAU OF LAND MANAGEMENT-OSO
BRANCH OF GEOGRAPHIC SCIENCES
LETTER OF AUTHORIZATION: MAY 9, 1996
DWG: HAYDEN

EXECUTED BY:
DANIEL E. WELLER, PLS, CWRE
P.O. BOX 2965
PORTLAND, OREGON 97208

CLAIM 373