


T. 37 S., R. 10 E., W.M.



4/1/97
8/27/99

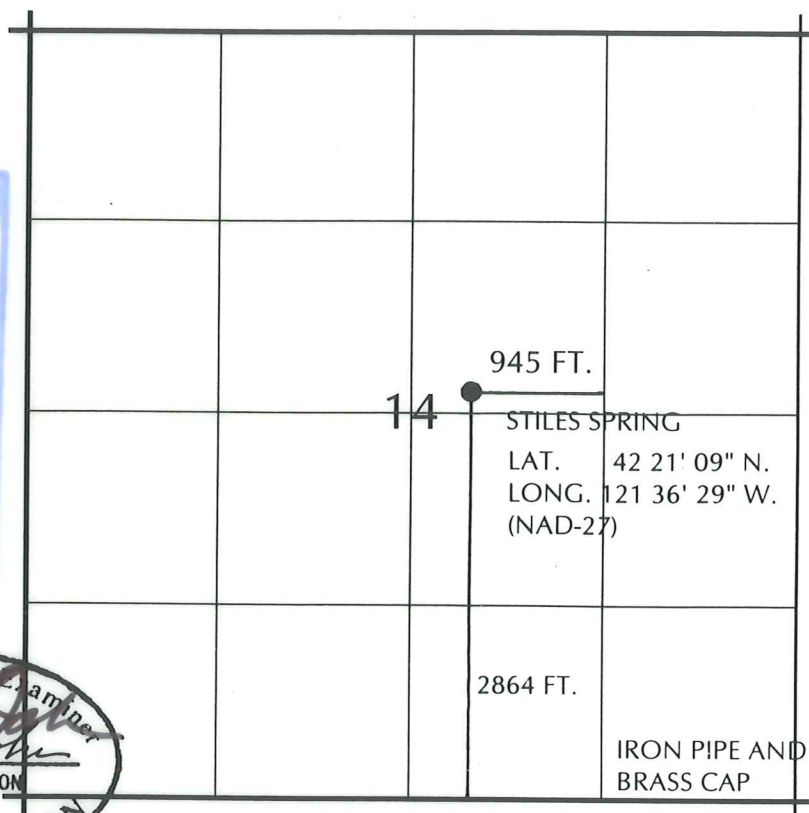

945 FT.

14

STILES SPRING

LAT. 42 21' 09" N.

LONG. 121 36' 29" W.

(NAD-27)

2864 FT.

IRON PIPE AND
BRASS CAP

STILES SPRING

IN NAME OF

UNITED STATES BUREAU OF LAND MANAGEMENT,
LAKEVIEW DISTRICT

FOR

FEDERAL RESERVED RIGHTS

JULY 24, 1993

BLM PROJECT NO. 49-4327

WRE 6236FRR, OREGON

THE PURPOSE OF THIS MAP IS FOR IDENTIFYING THE LOCATION OF THE WATER RIGHT AND
IS NOT INTENDED TO PROVIDE LEGAL DIMENSIONS OR LOCATION OF PROPERTY OWNERSHIP.

THE TIE WAS DETERMINED BY INVERSE BETWEEN A POSITION, THE SPRING, SCALED FROM THE SWAN LAKE, OREG,
PROVISIONAL QUADRANGLE, 1985 EDITION, AND A POSITION, FOR THE E 1/16 SEC. COR. OF SECS. 14 AND 23, DERIVED FROM A GLOBAL
POSITIONING SYSTEM, TRIMBLE PATHFINDER, WITH A POSITIONAL TOLERANCE OF 2-5 METERS, 50 PERCENT OF THE TIME.

U.S. BUREAU OF LAND MANAGEMENT - OSO
BRANCH OF GEOGRAPHIC SCIENCE

LETTER OF AUTHORIZATION
DATED: JUNE 15, 1993

EXECUTED BY;
RICHARD L. JOHNSON, PLS, CWRE
OR-957.1
P.O. BOX 2965
PORTLAND, OR. 97208

Claim 374

KLAMATH ADJUDICATION

CLAIM # 374 PAGE #