


T. 37 S., R. 12 E., W.M.

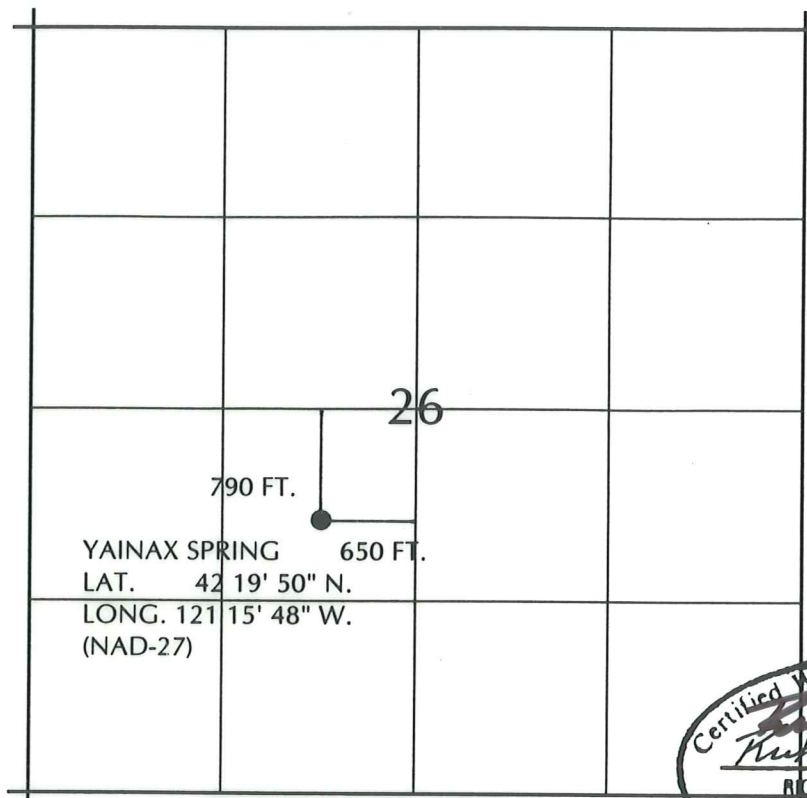

YAINAX SPRING
LAT. 42° 19' 50" N.
LONG. 121° 15' 48" W.
(NAD-27)



1 IN. = 1320 FT.

YAINAX SPRING

IN NAME OF

UNITED STATES BUREAU OF LAND MANAGEMENT,
LAKEVIEW DISTRICT

FOR

FEDERAL RESERVED RIGHTS

JUNE 21, 1993

BLM PROJECT NO. 47-4081

WRE 6234FRR, OREGON

THE PURPOSE OF THIS MAP IS FOR IDENTIFYING THE LOCATION OF THE WATER RIGHT AND
IS NOT INTENDED TO PROVIDE LEGAL DIMENSIONS OR LOCATION OF PROPERTY OWNERSHIP.

THE TIE WAS DETERMINED BY INVERSE BETWEEN A POSITION, THE SPRING, DERIVED FROM A GLOBAL POSITIONING SYSTEM,
TRIMBLE PATHFINDER, WITH A POSITIONAL TOLERANCE OF 2-5 METERS, 50 PERCENT OF THE TIME, AND A POSITION,
THE CENTER 1/4 SEC. COR. OF SEC. 26, SCALED FROM THE YAINAX BUTTE PROVISIONAL QUADRANGLE, 1988 EDITION.

U.S. BUREAU OF LAND MANAGEMENT - OSO
BRANCH OF GEOGRAPHIC SCIENCE

LETTER OF AUTHORIZATION
DATED: MAY 9, 1994

EXECUTED BY;
RICHARD L. JOHNSON, PLS, CWRE
OR-957.1
P.O. BOX 2965
PORTLAND, OR. 97208

Claim 375



KLAMATH ADJUDICATION
CLAIM # 375 PAGE # 7