


# TOWNSHIP 35 SOUTH, RANGE 7 EAST, W. M.

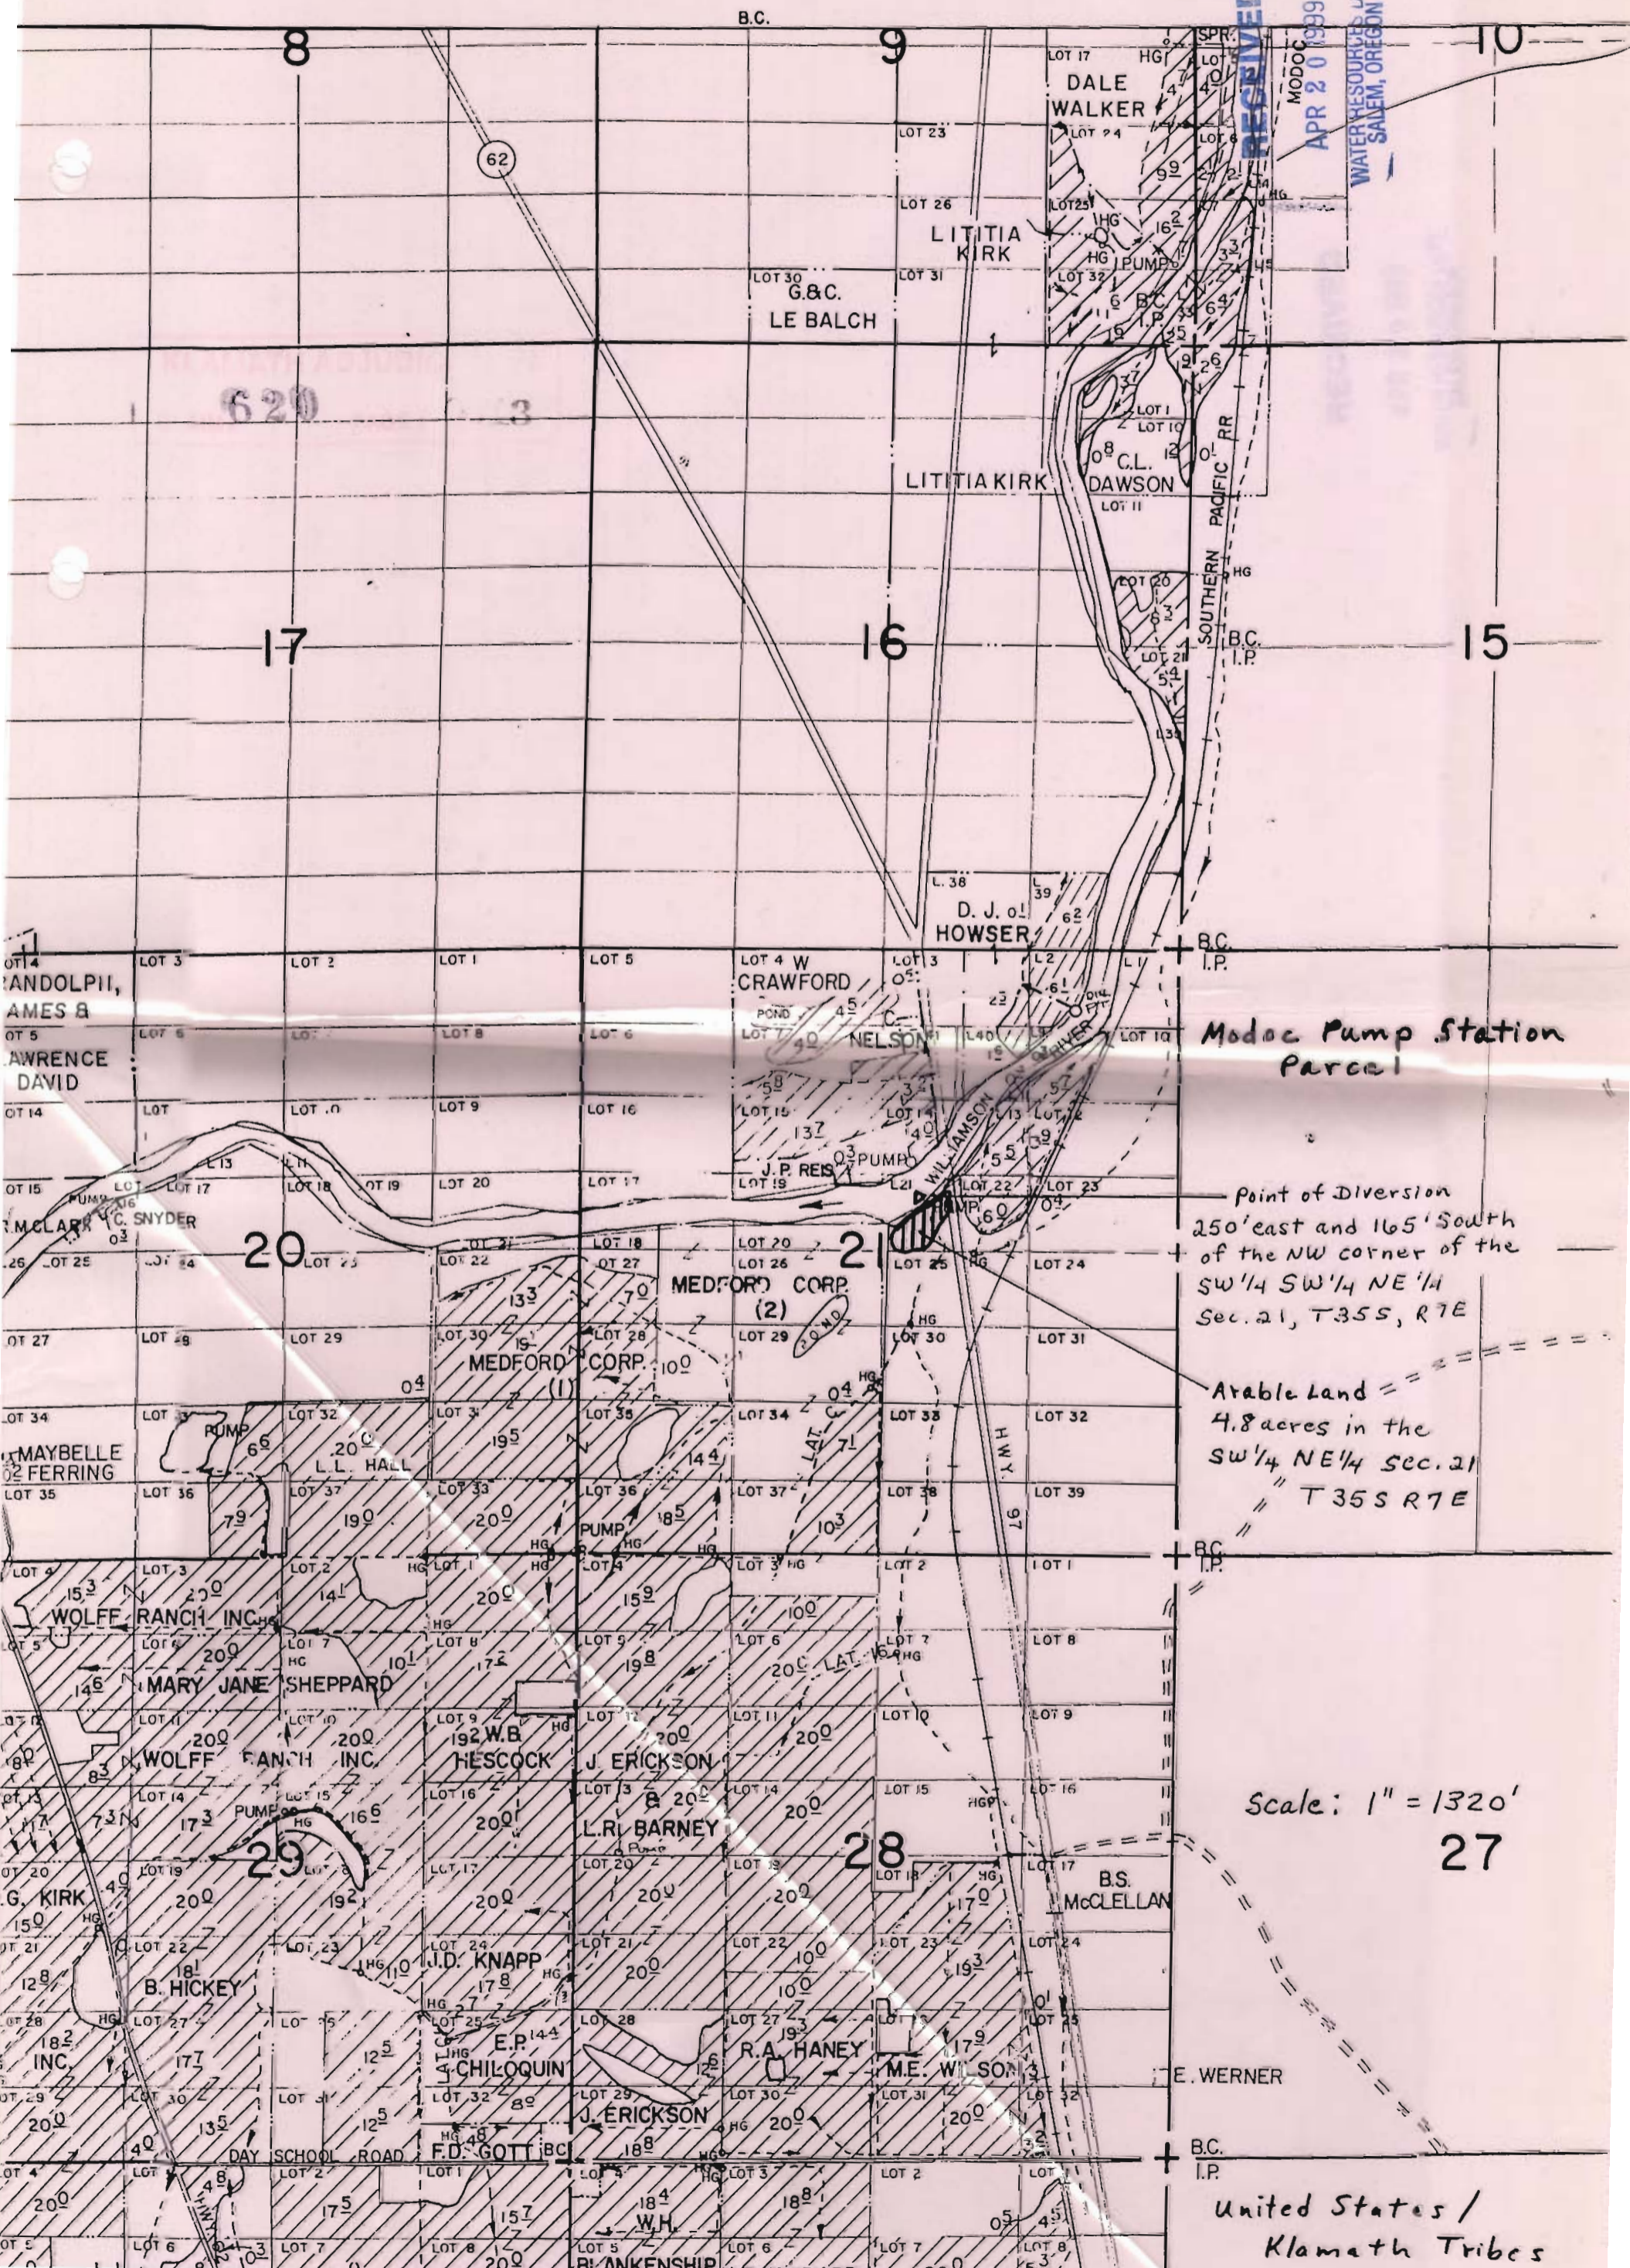

Modoc Pump Station Parcel

Point of Diversion  
250' east and 165' South  
of the NW corner of the  
SW<sup>1</sup>/<sub>4</sub> SW<sup>1</sup>/<sub>4</sub> NE<sup>1</sup>/<sub>4</sub>  
Sec. 21, T35S, R7E

Arable Land  
4.8 acres in the  
SW<sup>1</sup>/<sub>4</sub> NE<sup>1</sup>/<sub>4</sub> Sec. 21  
T35S R7E

Scale: 1" = 1320'

27

United States /  
Klamath Tribes