TOWNSHIP 36 SOUTH, RANGE 10 EAST, W. M.

Owner # 27, Property # 2

OWRD Claim # 690

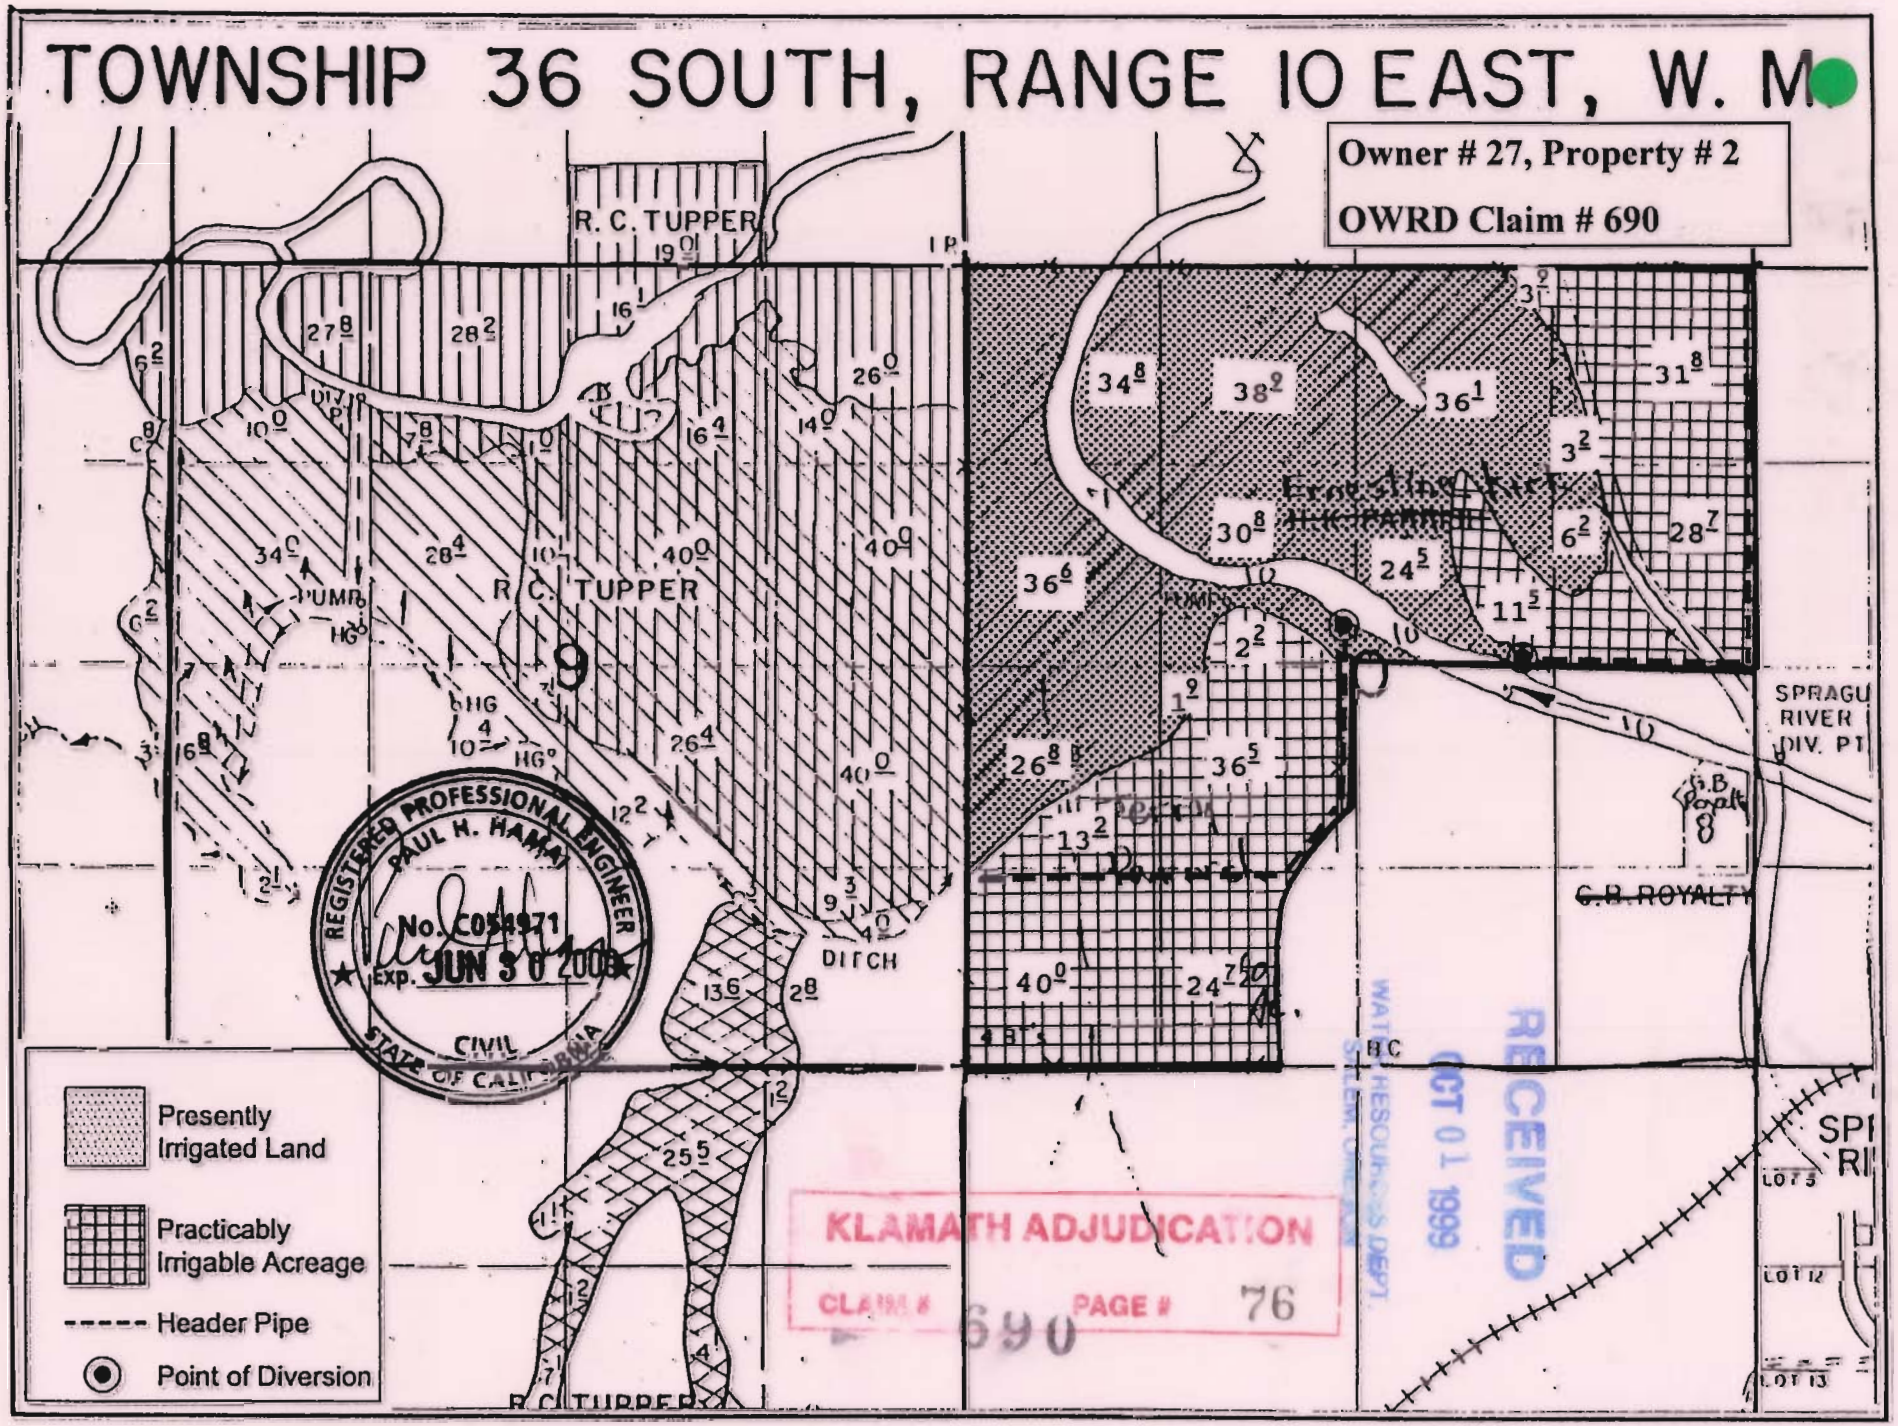

REGISTERED PROFESSIONAL ENGINEER
PAUL H. HAMA
No. C058971
EXP. JUN 30 2008
CIVIL
STATE OF CALIFORNIA

KLAMATH ADJUDICATION
CLAIM # 690 PAGE # 76

RECEIVED
OCT 01 1999
WATER RESOURCES DEPT.
SALEM, OREGON

By: Natural Resources Consulting Engineers Inc.
1250 Addison St., Suite 204
Berkeley, Ca. 94702
Berkeley (510)841-7814