


THIS MAP WAS PREPARED FOR
ASSESSMENT PURPOSE ONLY

SECTION 22 T5S R3W W.M.
YAMHILL COUNTY
1" = 400'

5 3 22

CANCELLED

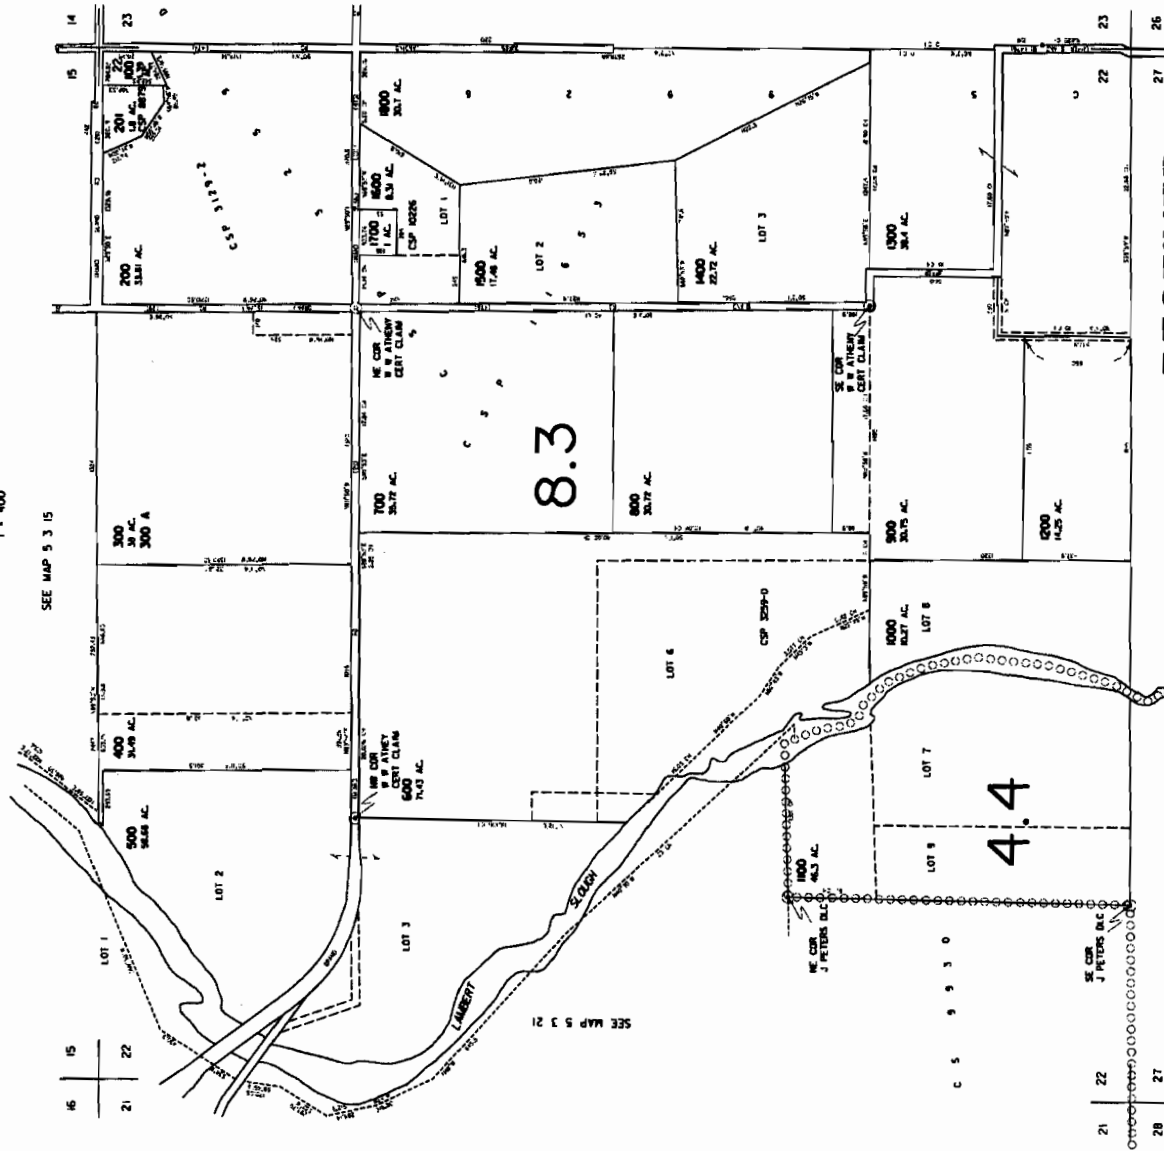

SEE MAP 5 3 23

SEE MAP 5 3 21

RECEIVED

OCT 30 2006

WATER RESOURCES DEPT
SALEM, OREGON

PRINTED 7-6-17-15

5 3 22

2230 ft
South
1230 ft
West
from
NE corner
SECTION 22

$$\begin{array}{r} \pm 11 \frac{9}{10} A \\ \hline 125 \\ \hline \pm 5 \frac{9}{10} A \\ \hline 5.23 A \end{array}$$

17.48 AC.