

Application No. GR 4228
Certificate No. GR 3767

Wm. J. and Carolyn K. Jackson
Rt. 2, Box 318
Milton-Freewater, Oregon

Stream Index, Page No. 7-48 ✓

short. 15¢ →

FEEES PAID

Date	Amount	Receipt No.
8/5/58	15.00	19652

FEEES REFUNDED

Date	Amount	Check No.

led August 4, 1958 *1:00 PM*
ve priority *1895*

suspended until

g filed

ASSIGNMENTS

Date	To Whom	Address	Volume	Page

CONSTRUCTION

r completion
ended to

r application of water
ended to

REMARKS

*A well irrigates 31.5 acres near Wallawalla River - Umatilla County
Short 15¢ fees*

PROSECUTION OF WORK

B" filed
C" filed

STATE ENGINEER
Salem, Oregon

UMAT
4919

Well Record

STATE WELL NO. 6N/35-33
COUNTY Umatilla
APPLICATION NO. GR-4228

OWNER: Wm. J. & Carolyn K. Jackson


MAILING ADDRESS: Route 2, Box 318

LOCATION OF WELL: Owner's No. _____

CITY AND STATE: Milton-Freewater, Oregon

SE 1/4 NE 1/4 Sec. 33 T. 6 N. S. R. 35 W., W.M.

Bearing and distance from section or subdivision
corner 100' W. & 150' N. of E¹ Cor. Sec. 33

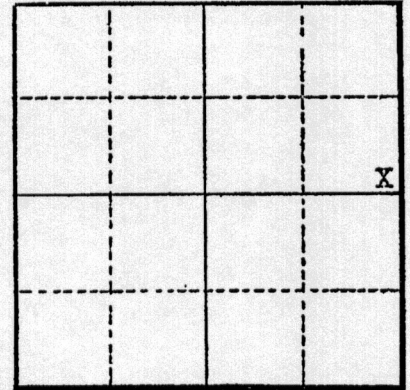

Section 33

Altitude at well _____

TYPE OF WELL: Drill ^{Dug 75'} 120' Date Constructed 1895

Depth drilled 120 ft. Depth cased _____

CASING RECORD:

FINISH:

AQUIFERS:

WATER LEVEL:

30 feet below surface

PUMPING EQUIPMENT: Type Peerless turbine H.P. 1
Capacity 600 G.P.M.

WELL TESTS:

Drawdown _____ ft. after _____ hours _____ G.P.
Drawdown _____ ft. after _____ hours _____ G.P.

USE OF WATER Irrigation Temp. _____ °F. _____, 19

SOURCE OF INFORMATION Well Registration Statement Cert. # GR-3767

DRILLER or DIGGER _____

ADDITIONAL DATA:

Log _____ Water Level Measurements _____ Chemical Analysis _____ Aquifer Test _____

REMARKS:

Registration Statement

OF CLAIMANT OF RIGHT TO APPROPRIATE GROUND WATER

TO THE STATE ENGINEER OF OREGON:

I, ^{Wc} Wm. J. + Carolyn K. Jackson
of RT. 2, Box 318 Milton-Freewater County of Umatilla
(Mailing address)

State of Oregon, do hereby make application for a certificate of registration as evidence of a right to appropriate ground water.

- 1. Source from which water is withdrawn is Pumped Well
(Flowing well, pump well, infiltration trench, or tunnel)
- 2. Location is: 2 1/2 miles N.W. Milton-Freewater
(Approximate distance and direction from nearest city or town)

and is more particularly described as follows:

(a) 100 feet west of 150 feet N. of E. 1/4 Corner of Sec. 33
(Give distance and bearing to corner of section or other legal subdivision)
being within SE 1/4 of SE 1/4 of NE 1/4 of Sec. 33, Twp. 6N, Rge. 35E
(Smallest legal subdivision) (N. or S.) (E. or W.)

or (b) within limits of recorded platted property, town or city:
in Lot _____, Block _____ of _____
(Name of plat or addition)
_____ County of _____
(If within city or town, give name)

3. Construction Work was begun on 1895; was completed on 1895
(Date) (Date)
and the ground water claimed was first used for the purposes set out below on 1895
(Date)

since which time the water has been used Continuously
(Continuously or Intermittently)
from May 15 to Sept. 15
(Date) (Date)

4. Quantity of water claimed and used is 600 down to 450 gallons per minute; 240 acre
feet per year.

5. Purpose or Purposes for which water is used Irrigation
(Domestic, irrigation, municipal, manufacturing, industrial, etc.)

6. Description of Well: Depth 120 feet. Type Dug 75' Drilled to 120'
(Dug or drilled)
diameter 8" inches. Elevation of ground at well site 9.75 feet, mean sea level.
(As near as known)
Depth to water table 30 feet.

7. Capacity of Well: _____ g.p.m. with _____ feet drawdown.
_____ g.p.m. with _____ feet drawdown.
Date of test _____

If Flowing Well: Measured discharge _____ g.p.m. on _____
(Date)
Shut-in pressure at ground surface _____ lbs. per sq. in. on _____
(Date)
Water is controlled by _____
(Cap, valve, etc.)

If log of well is not available, give name and address of driller.?

11. Infiltration Trench: Covered or open

Dimensions: Length ft. Minimum depth ft. Maximum depth ft.

Bottom width ft. Discharge g.p.m. Date of test

12. Tunnel: Type of lining

Dimensions:
(Length, course, and cross sectional size)

Position of water bearing stratum with reference to portal of tunnel

Log of tunnel: (Preceding table for log of well may be used, if desired. Give footage from portal and character of materials, as pertinent.)

13. Pumping Equipment:

(a) Pump Peerless Turbine Capacity 600 g.p.m.
(Make, type and size)

(b) Motor 10 HP. Electric
(Type and horsepower)

14. Location of area irrigated or to be irrigated, or place of use if for purposes other than irrigation.

Township North or South	Range E. or W. of Willamette Meridian	Section	Forty-acre Tract	Number Acres To Be Irrigated	Date of Reclamation
6N	35E	33	SE 1/4 NE 1/4	25 1/2 Ac	1895
"	"	"	SW 1/4 of NE 1/4	6 1/2 Ac	1895


15. If the ground water supply is supplemental to an existing water supply, identification of any application for a permit, permit, certificate or adjudicated right to appropriate water made or held by the registrant.

Pleasant View Ditch Permit (Surplus)
Walla Walla — W.V. Staley

GR. 3767

Township 6N Range 35E, W.M.

North

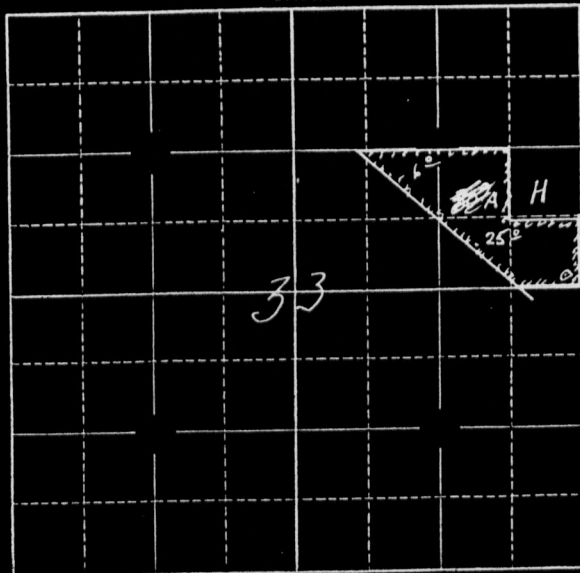

Well Location
100 feet West
+ 150 feet North
E⁴ Corner of Sec 33

Locate well and acreage of irrigated land on plat.

Scale: $\frac{1}{4}$ = 1 Mile

STATE OF OREGON

County of Umatilla

ss.

I, Mr. Lewis D. Jackson, being first duly sworn, do hereby certify that I have read the foregoing Registration Statement and that all of the items therein contained are true to the best of my knowledge and belief.

Mr. Lewis D. Jackson
(Signature of Registrant)

Subscribed and sworn to before me this 31st day of July, 1958.

My commission expires October 6th 1960
J. R. Doade
(Notary Public for Oregon)

(SEAL)

CERTIFICATE OF REGISTRATION

STATE OF OREGON

County of Marion

ss.

This is to certify that the foregoing Registration Statement was received in the office of the State Engineer on the 4th day of August, 1958, at 1:00 o'clock P.M. and has been duly recorded in said office in Book No. 15 of Registration Statements on page GR-3767

Witness my hand this 20th day of October, 1959.

W. A. Stanley
(State Engineer)

By _____
(Deputy)

#15-15

GR. 3767

GR-4228

Wm. J. Jackson
Rt. 2, Box 318
Milton-Freewater, Oregon

Dear Sir:

GR-4228
GR-3767

Aug. 13, 1958

Wm. J. & Carolyn K. Jackson
Route 2, Box 318
Milton-Freewater, Oreg.

Dear Sir & Madam:

4 60.00
19650, 19651, 19652, 19653

4228, 4229, 4182, 4183