


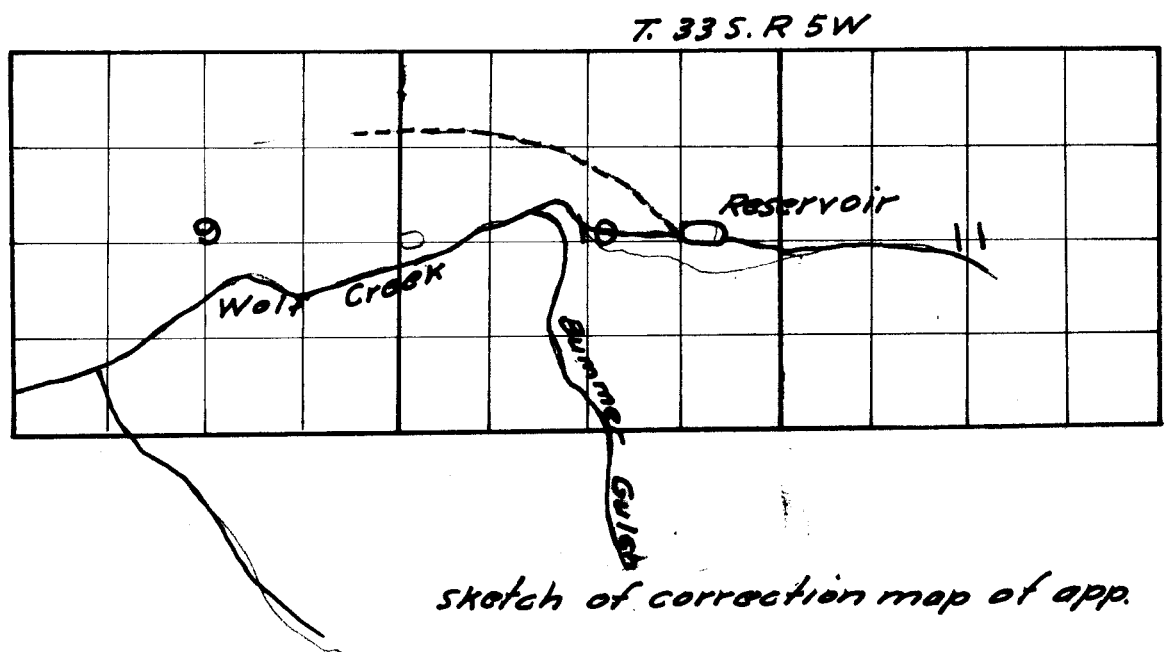

A-7012