

Kawak Butte

RECEIVED BY OWRD

RECEIVED BY OWRD

NOV 21 2012

SALEM, OR

RECEIVED BY OWRD

NOV 21 2012

SALEM, OR

Water Well S-16

Water Well WW 2


Water Well S-29

Creek


Paulina Creek Falls

PAULINA

66-1441

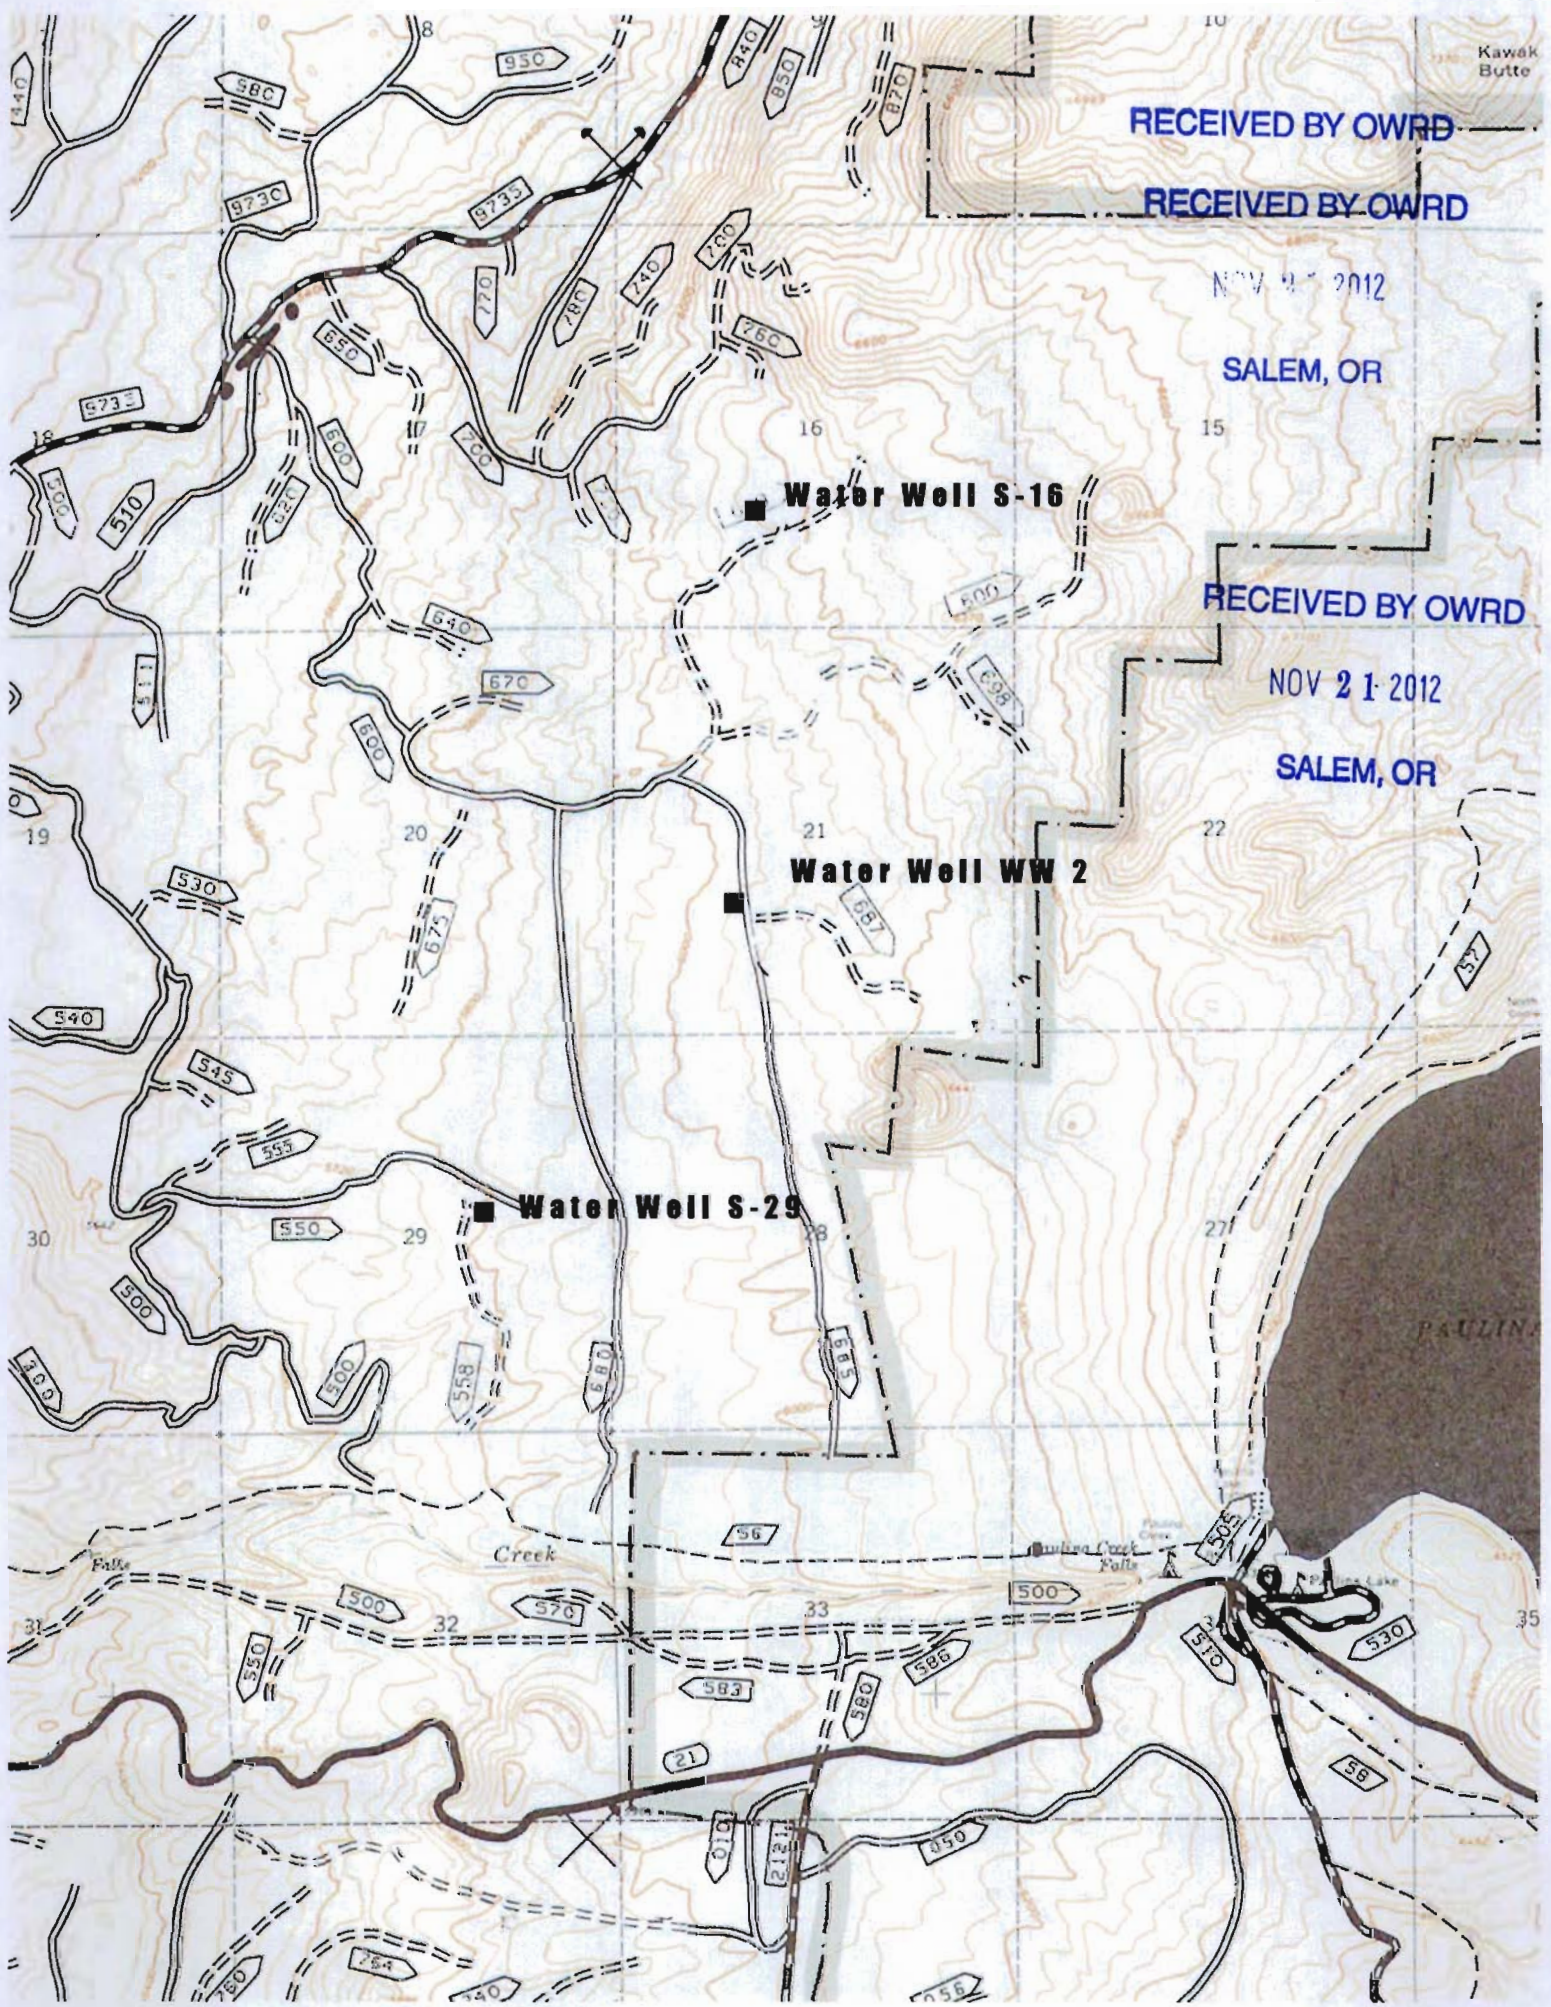

66-1441

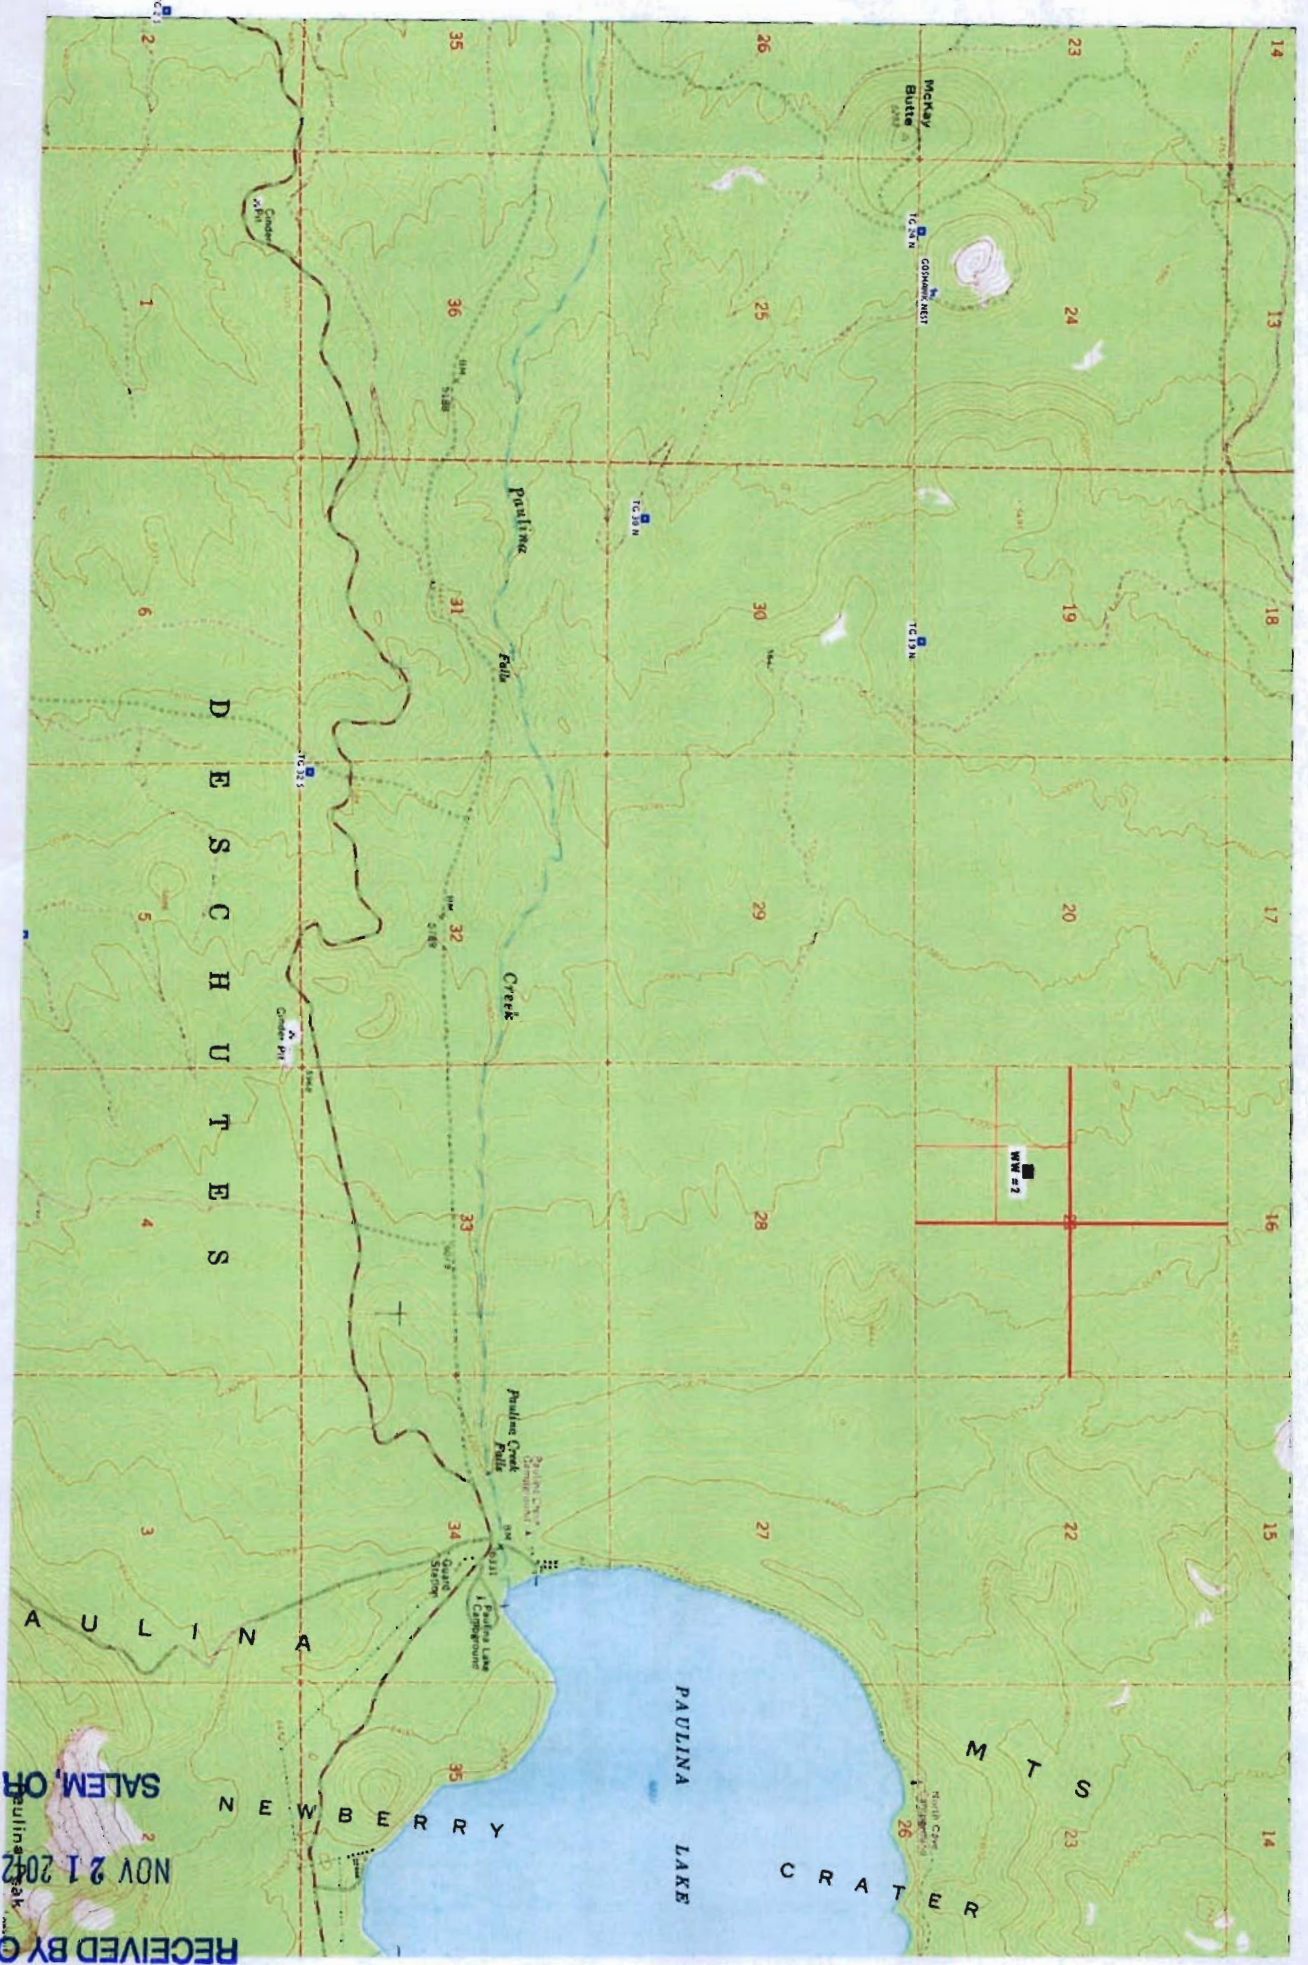

RECEIVED BY OWRD

NOV 21 2012
SALEM, OR
Paulina Lake